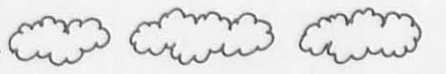



LOGAN COUNTY

C.R. 29 OVER MAD RIVER

BRIDGE NUMBER 29-2.70

CONVENTIONAL SIGNS

- TOWNSHIP LINE
- SECTION LINE
- CENTER LINE
- EXISTING RIGHT OF WAY..... Exist. R/W
- PROPOSED RIGHT OF WAY.....
- PROPERTY LINE..... P
- TREES (EXISTING)..... 
- TREES (TO BE REMOVED)..... 


INDEX OF SHEETS

- TITLE SHEET..... 1
- TYPICAL SECTION..... 2
- GENERAL NOTES, SUPERELEVATION TABLE, GENERAL SUMMARY..... 3
- PLAN and PROFILE..... 4
- CROSS SECTIONS C.R.#29 & TR #166..... 5-10
- CROSS SECTIONS CHANNEL..... 11
- STRUCTURES OVER 20'..... 12-19


LINE DATA

END WORK STA. 7+00
 BEGIN WORK STA. 0+02
 NET LENGTH OF WORK 698.00 L.F. = 0.132 Mi.

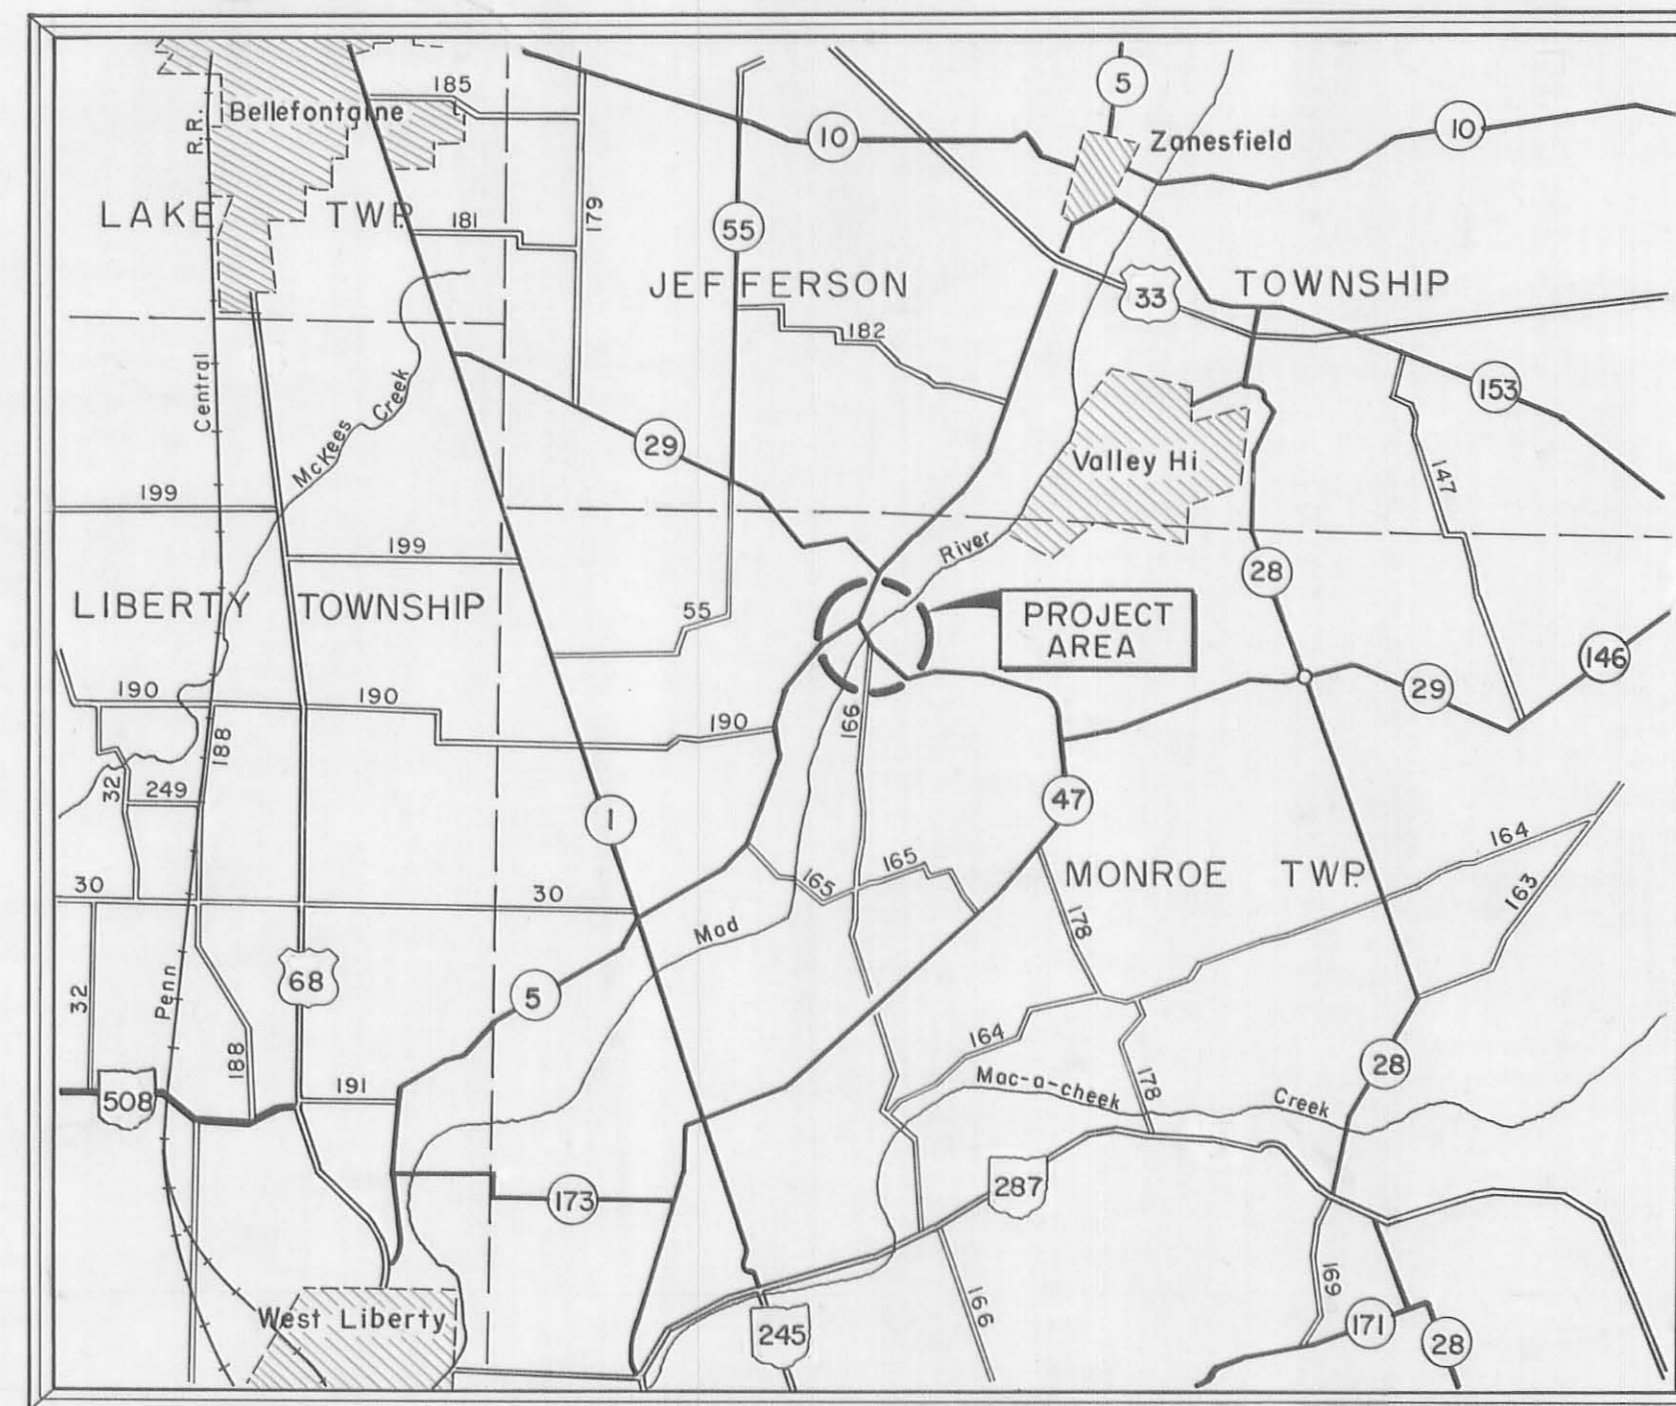





END PROJECT STA. 5+93.47
 BEGIN PROJECT STA. 0+02.
 NET LENGTH OF PROJECT 591.47 L.F. = 0.112 Mi.

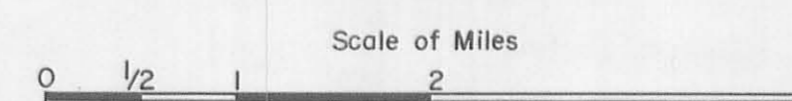

LOCATION MAP



LEGEND

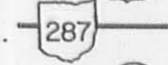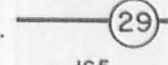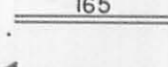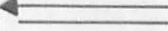- PORTION TO BE IMPROVED..... 
- U.S. HIGHWAY..... 
- STATE HIGHWAY..... 
- COUNTY ROADS..... 
- TOWNSHIP ROADS..... 
- DETOUR..... 

1975 SPECIFICATIONS

EXCEPT WHERE OTHERWISE NOTED, THE STANDARD SPECIFICATIONS OF THE STATE OF OHIO, DEPT. OF TRANSPORTATION, INCLUDING CHANGES AND SUPPLEMENTAL SPECIFICATIONS LISTED IN THE PROPOSAL, SHALL GOVERN THIS IMPROVEMENT.

WE, THE COMMISSIONERS OF LOGAN COUNTY, OHIO IN FORMAL SESSION HEREBY APPROVE THESE PLANS AND CERTIFY THAT THE RIGHT OF WAY IS AVAILABLE.

APPROVED Warren W. Smith

APPROVED Donald E. Leavin

APPROVED Shelby Kennedy COMMISSIONERS

DATE _____

APPROVED Chester R. Kutz, P.E. & P.S. LOGAN COUNTY ENGINEER


DATE _____

| STANDARD | | DRAWINGS | |
|----------|---------|----------|---------|
| BP-5 | 6-1-72 | MC-3 | 6-1-73 |
| | | MC-4 | 6-13-69 |
| GR-2A | 1-1-71 | | |
| GR-2B | 11-9-71 | | |
| GR-3 | 11-9-71 | | |

PLANS PREPARED BY
ERIKSSON ENGINEERING, LTD.
 COLUMBUS, OHIO




NOTE:
EARTHWORK LIMITS ARE SCHEMATIC.
ACTUAL SLOPES SHALL CONFORM TO
PLAN CROSS SECTION.

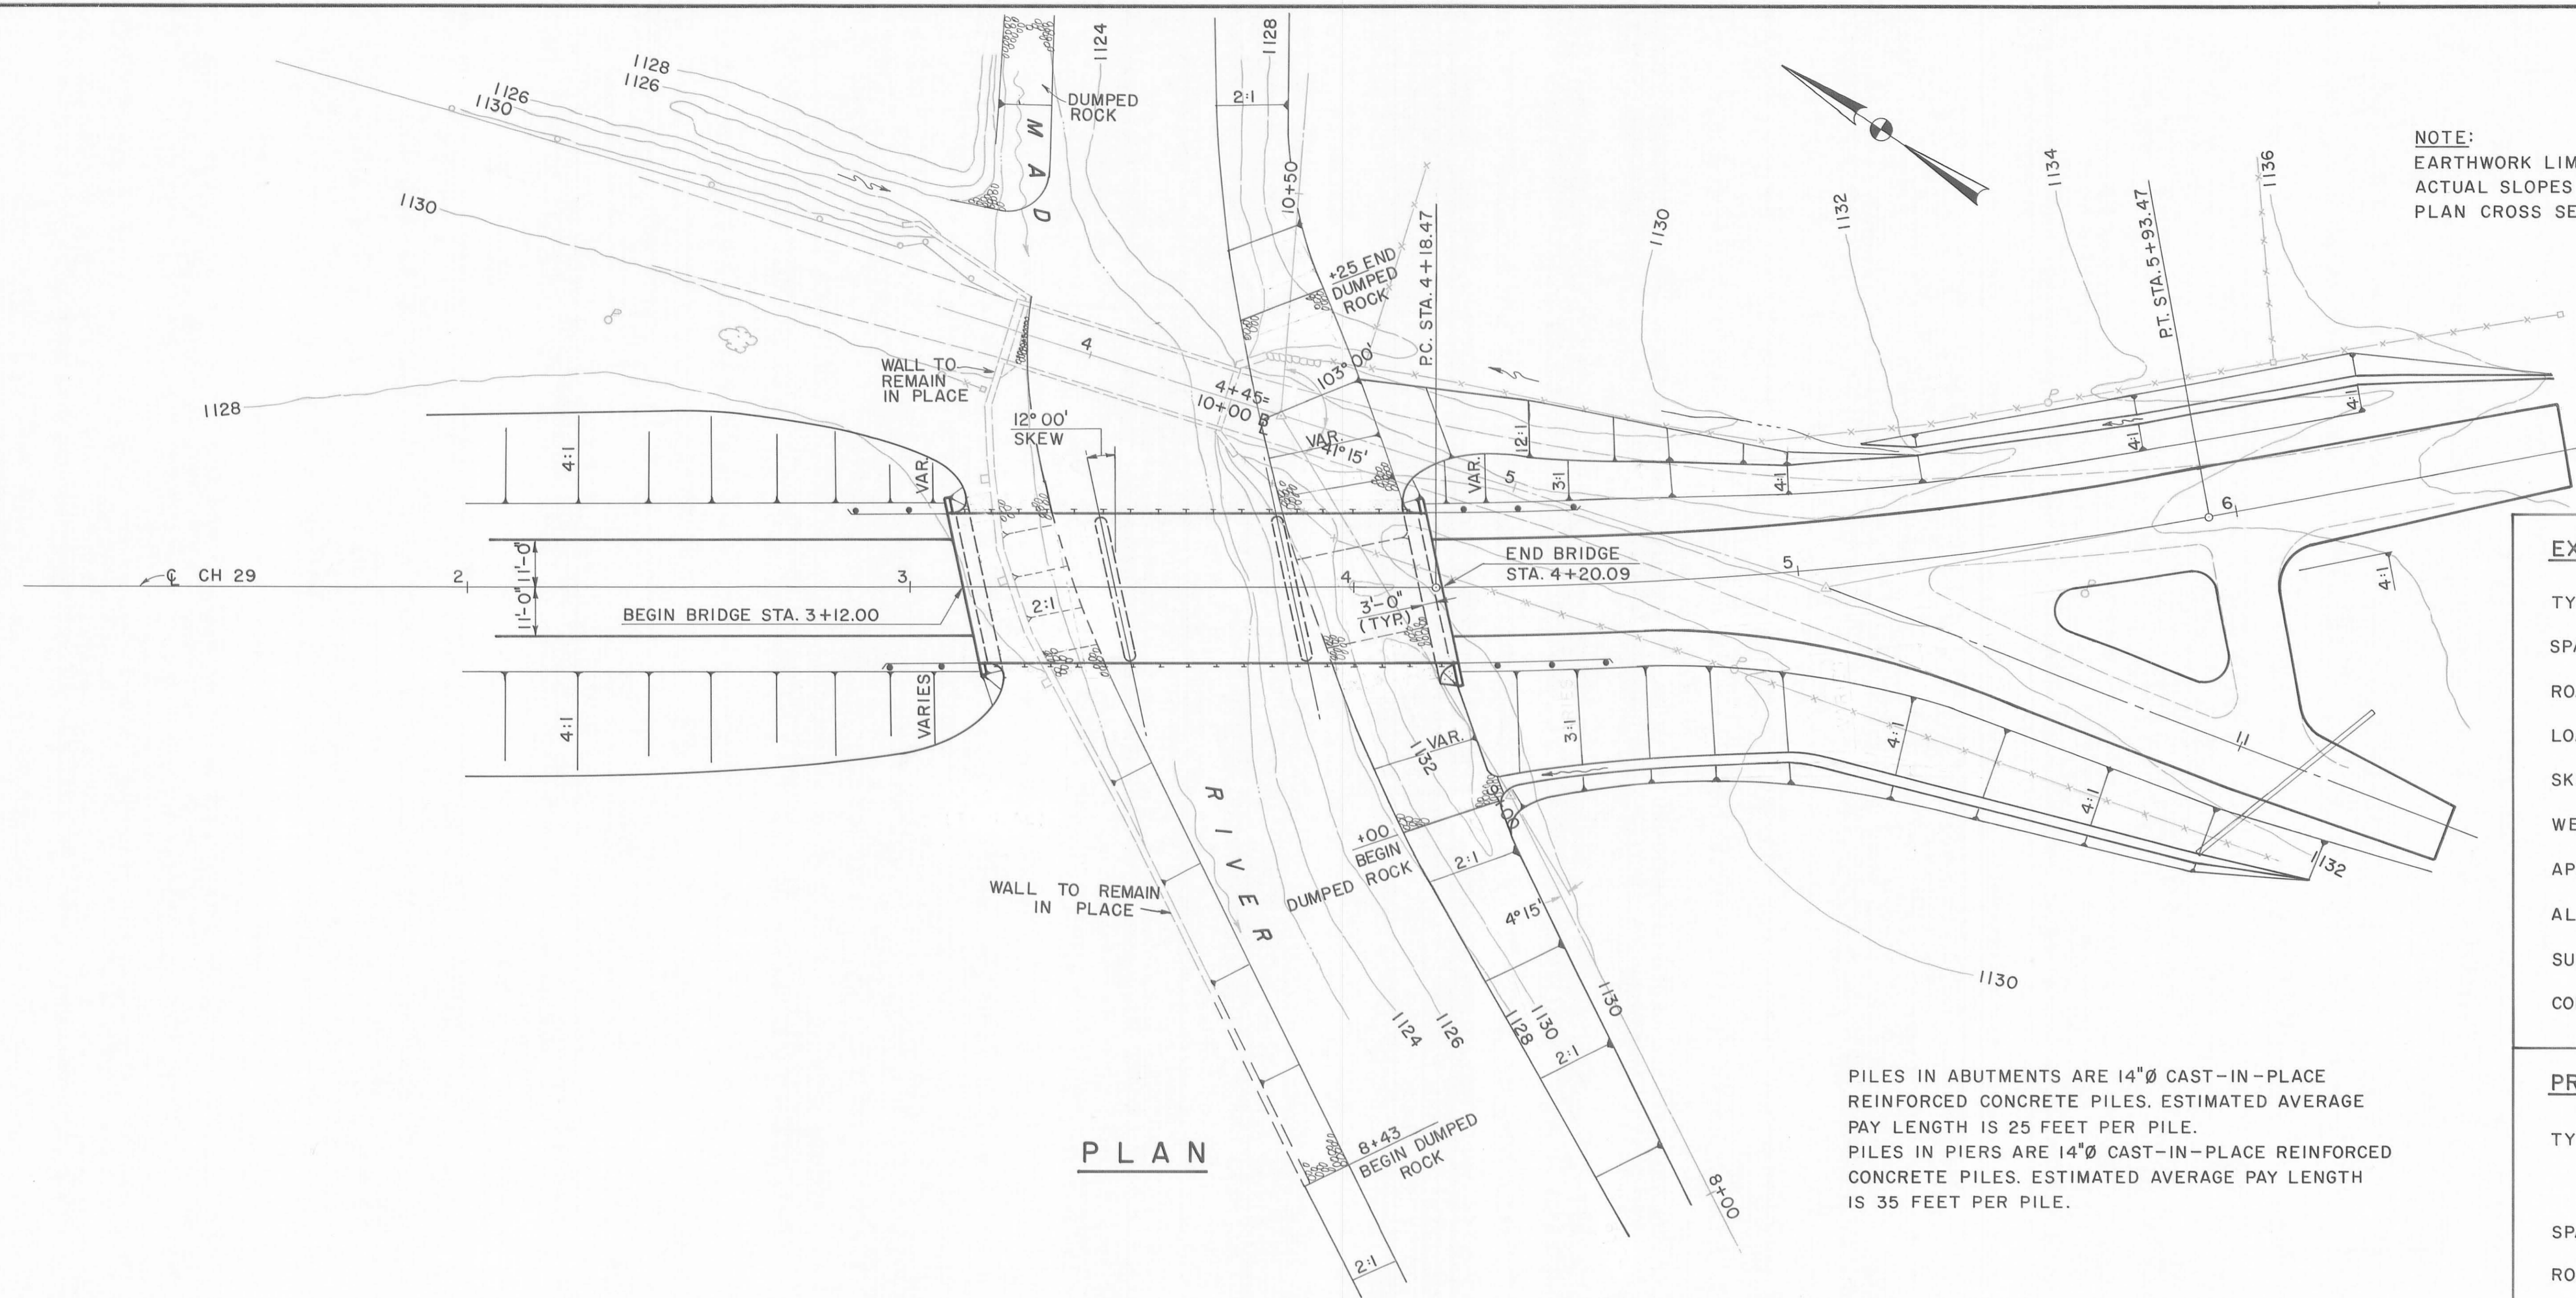

PLAN

PILES IN ABUTMENTS ARE 14"Ø CAST-IN-PLACE REINFORCED CONCRETE PILES. ESTIMATED AVERAGE PAY LENGTH IS 25 FEET PER PILE.
PILES IN PIERS ARE 14"Ø CAST-IN-PLACE REINFORCED CONCRETE PILES. ESTIMATED AVERAGE PAY LENGTH IS 35 FEET PER PILE.

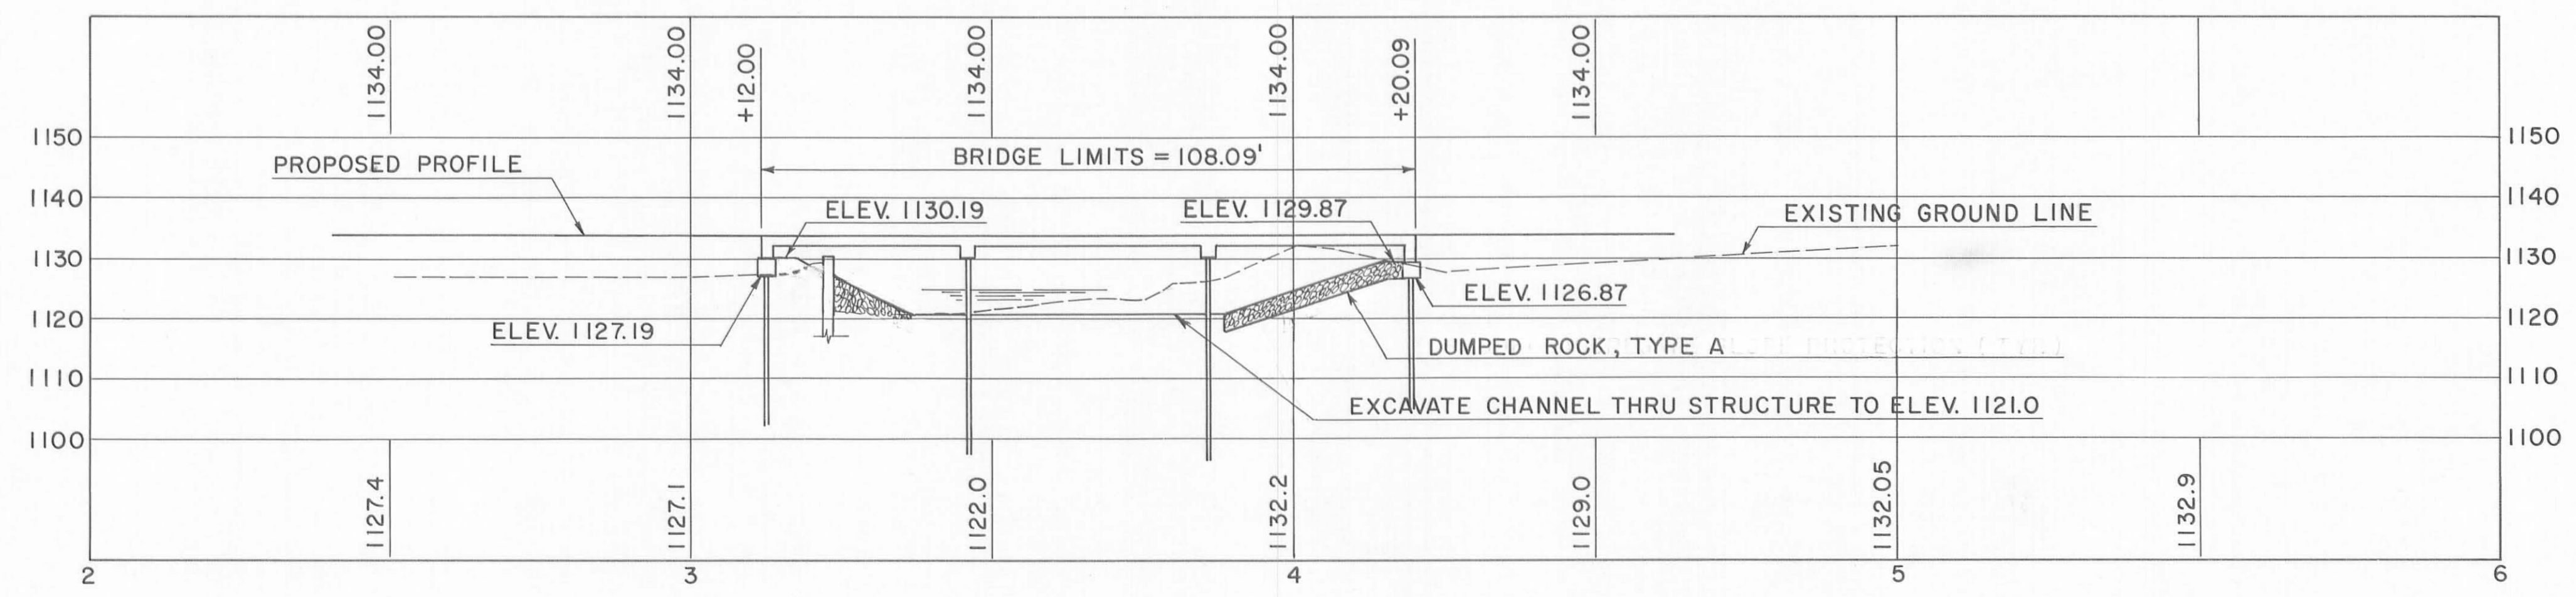

PROFILE

EXISTING STRUCTURE

TYPE: STEEL TRUSS (PRATT)
SPANS: 52'-0"
ROADWAY: 13.1'
LOADING: UNKNOWN
SKEW: 0°
WEARING SURFACE: BITUMINOUS
APPROACH SLABS: NONE
ALIGNMENT: TANGENT
SUPERELEVATION: NONE
CONDITION: UNSATISFACTORY

PROPOSED STRUCTURE

TYPE: THREE SPAN CONTINUOUS REINFORCED CONCRETE SLAB & CAPPED PILE SUBSTRUCTURES
SPANS: 32'-0", 40'-0", 32'-0"
ROADWAY: 34'-0" F/F GUARDRAILS
LOADING: HS 20-44
SKEW: 12° 00' 00" R.F.
WEAR SURFACE: 1" MONOLITHIC CONC.
APPROACH SLABS: NONE
ALIGNMENT: TANGENT
SUPERELEVATION: VARIES
DRAINAGE AREA: 26.1 SQ. MILES

ERIKSSON ENGINEERING
COLUMBUS OHIO

SITE PLAN

BRIDGE NO. 29-2.70
C.H. 29 OVER MAD RIVER
LOGAN COUNTY, STA. 3+12.00 TO STA. 4+20.09

| Designed | Drawn | Checked | Reviewed | Date | Revised |
|----------|-------|---------|----------|---------|---------|
| J.B. | G.S. | 688 | | 5-20-75 | |

GENERAL NOTES

REFERENCE SHALL BE MADE TO SUPPLEMENT SPECIFICATIONS:
808 DATED 1-1-71
836 DATED 1-1-71

DESIGN SPECIFICATIONS: THIS STRUCTURE CONFORMS TO "STANDARD SPECIFICATIONS FOR HIGHWAY BRIDGES" ADOPTED BY THE AMERICAN ASSOCIATION OF STATE HIGHWAY OFFICIALS, 1973, INCLUDING THE OHIO "SUPPLEMENT" TO THESE SPECIFICATIONS.

DESIGN DATA:
DESIGN LOADING - HS 20-44
CONCRETE CLASS C - UNIT STRESS 1200 P.S.I. FOR SUPERSTRUCTURE
- UNIT STRESS 1333 P.S.I. FOR SUBSTRUCTURE
REINFORCING STEEL - ASTM A615, A616 OR A617 - UNIT STRESS 20,000 P.S.I.

EMBANKMENT CONSTRUCTION: THE EMBANKMENTS SHALL BE CONSTRUCTED TO THE LEVEL OF THE SUBGRADE FOR A MINIMUM DISTANCE OF 50 FEET BACK OF THE ABUTMENTS; EXCAVATION SHALL THEN BE MADE FOR THE ABUTMENTS AND FOR THE BENCHES.

PILES SHALL BE DRIVEN TO A MINIMUM BEARING CAPACITY OF 28 TONS PER PILE FOR THE ABUTMENTS AND 40 TONS PER PILE FOR THE PIERS.


REMOVAL OF EXISTING STRUCTURE: WHEN NO LONGER NEEDED TO MAINTAIN TRAFFIC THE EXISTING STRUCTURE SHALL BE REMOVED. SUITABLE WASTE MASONRY MAY BE PLACED AS BANK PROTECTION AS DIRECTED BY THE ENGINEER.

CONCRETE SURFACE TREATMENT: THE TOP, ALL FOUR SIDES, AND THE UNDERSIDES TO THE DRIP GROOVE OF THE CONCRETE DECK, AND ALL SIDES OF THE ABUTMENTS AND WINGWALLS ABOVE THE FOOTINGS SHALL BE TREATED WITH SINMAST DEEP CONSERVATION.


MATERIALS AND APPLICATION SHALL BE AS SPECIFIED BY THE SINMAST OF AMERICA CORPORATION FOR ITS DEEP CONSERVATION TREATMENT. COPIES OF THESE SPECIFICATIONS ARE AVAILABLE AT THE COUNTY ENGINEER'S OFFICE.

| ITEM | ESTIMATED | | | QUANTITIES | | | | AS BUILT | |
|---------|-----------|----------|---|------------|-------|-------|------|----------|--|
| | TOTAL | UNIT | DESCRIPTION | SUPER. | PIERS | ABUT. | GEN. | | |
| 202 | LUMP | SUM | STRUCTURE REMOVED | | | | LUMP | | |
| 503 | 82 | CU. YD. | UNCLASSIFIED EXCAVATION | | | 82 | | | |
| 507 | 840 | LIN. FT. | 14" CAST-IN-PLACE REINFORCED CONCRETE PILES | | 490 | 350 | | | |
| 509 | 52,441 | LB. | REINFORCING STEEL | 45,071 | 2,842 | 4,528 | | | |
| 511 | 211 | CU. YD. | CLASS C CONCRETE, SUPERSTRUCTURE | 211 | | | | | |
| 511 | 12 | CU. YD. | CLASS C CONCRETE, PIER CAPS | | 12 | | | | |
| 511 | 42 | CU. YD. | CLASS C CONCRETE, ABUTMENTS | | | 42 | | | |
| 517 | 216.18 | LIN. FT. | RAILING (DEEP BEAM RAIL WITH STEEL POSTS AND BOLTS) | 216.18 | | | | | |
| 518 | 13 | CU. YD. | POROUS BACKFILL | | | 13 | | | |
| SPECIAL | LUMP | SUM | CONCRETE SURFACE TREATMENT | | | | | | |
| 808 | 211 | UNIT | CHEMICAL ADMIXTURE FOR CONCRETE, TYPE A, B, OR D | 211 | | | | | |


| | | | | | |
|---|-------|------------|----------|---------|---------|
| ERIKSSON ENGINEERING COLUMBUS OHIO | | | | | |
| GENERAL NOTES & ESTIMATED QUANTITIES | | | | | |
| BRIDGE NO. 29 - 2.70 C.H. 29 OVER MAD RIVER | | | | | |
| LOGAN COUNTY, STA. 3+12.00 TO STA. 4+20.09 | | | | | |
| Designed | Drawn | Checked | Reviewed | Date | Revised |
| V. K. | G. S. | <i>lll</i> | | 5-20-75 | |

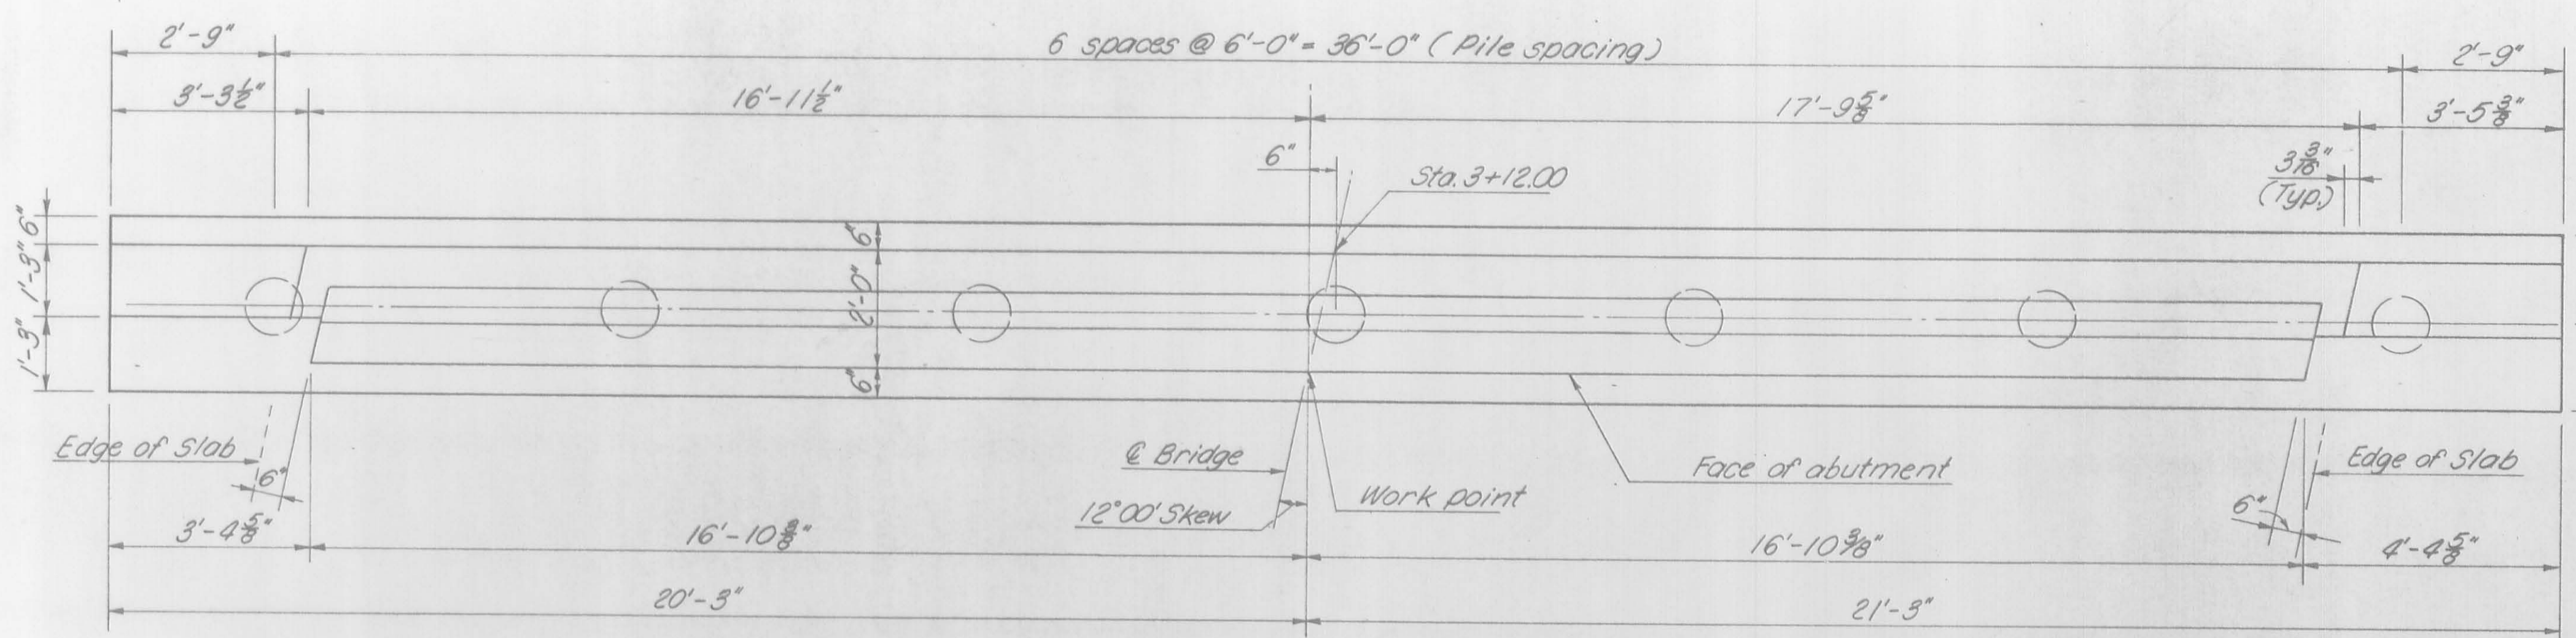


PLAN

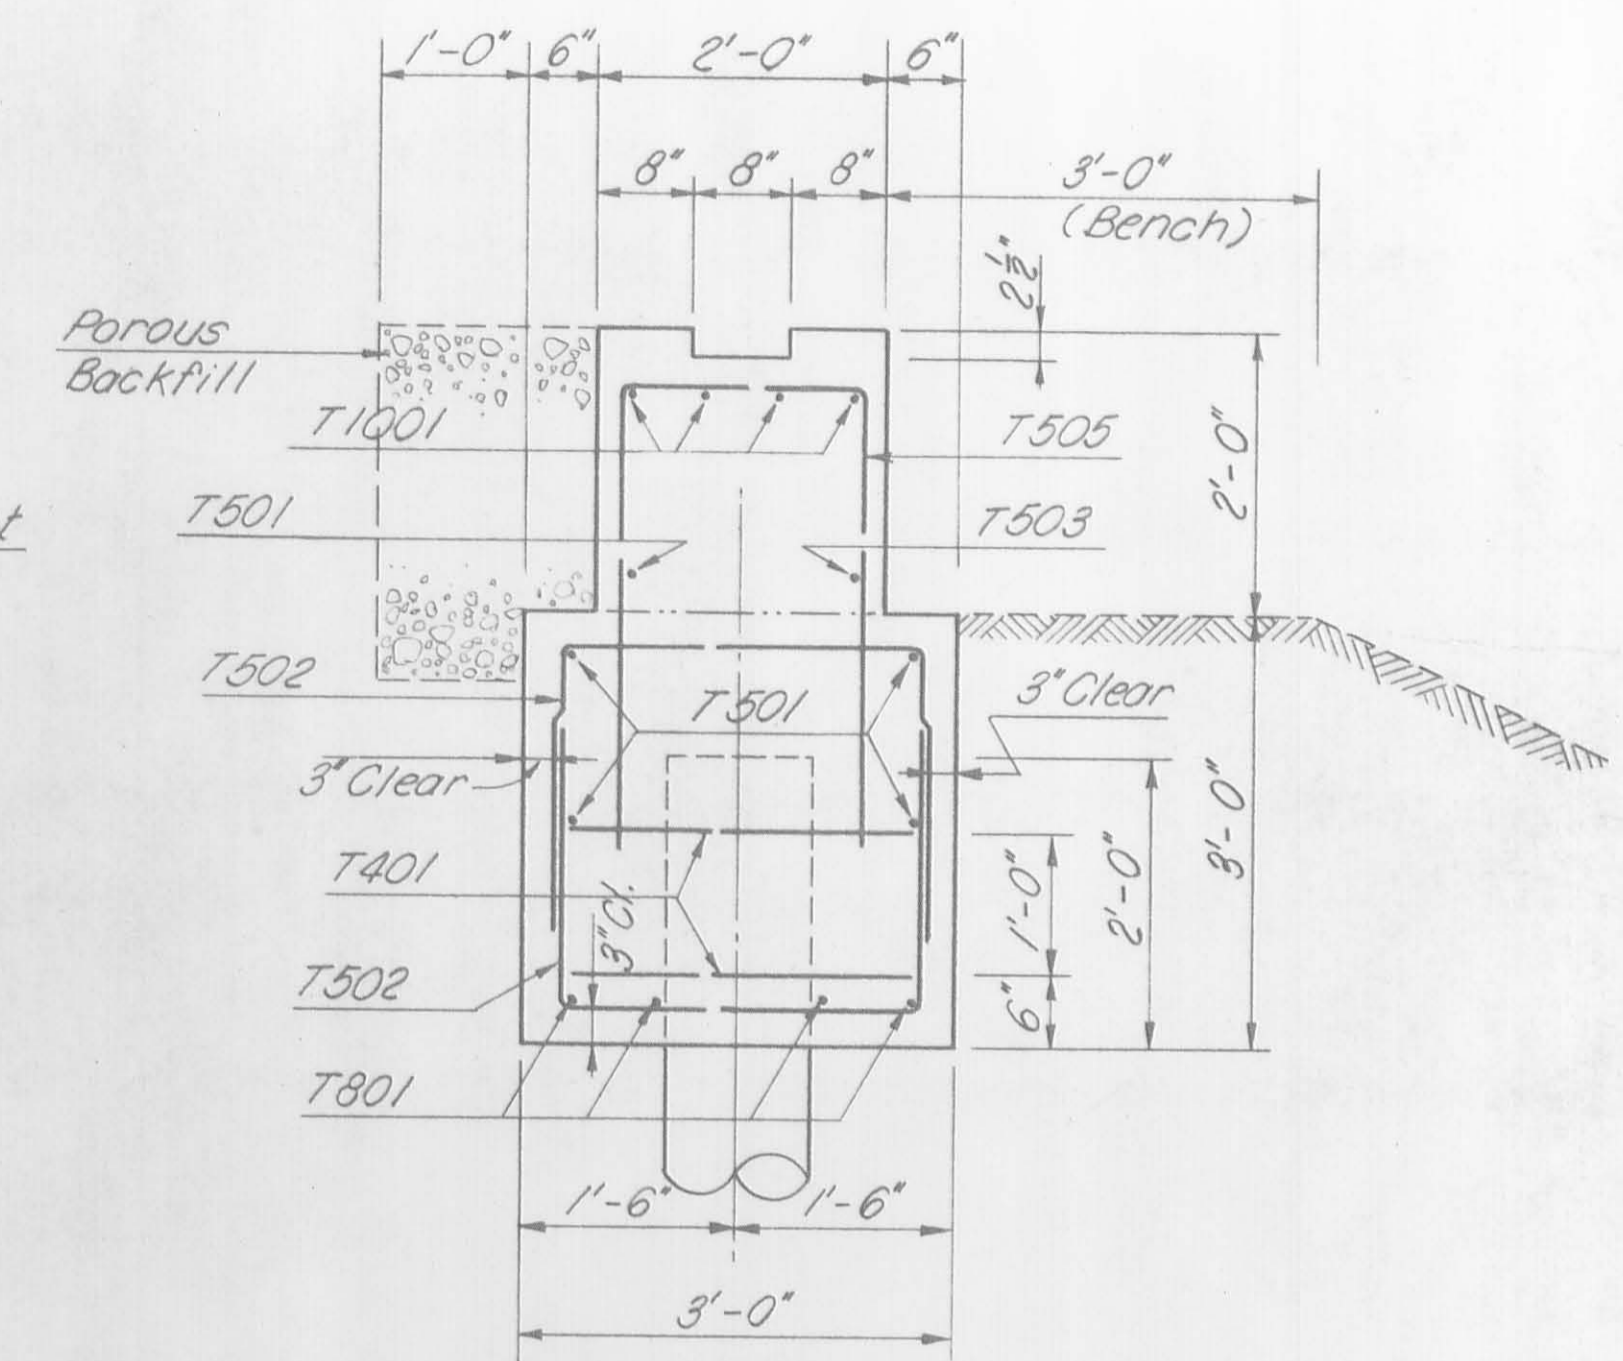

SECTION "A-A"

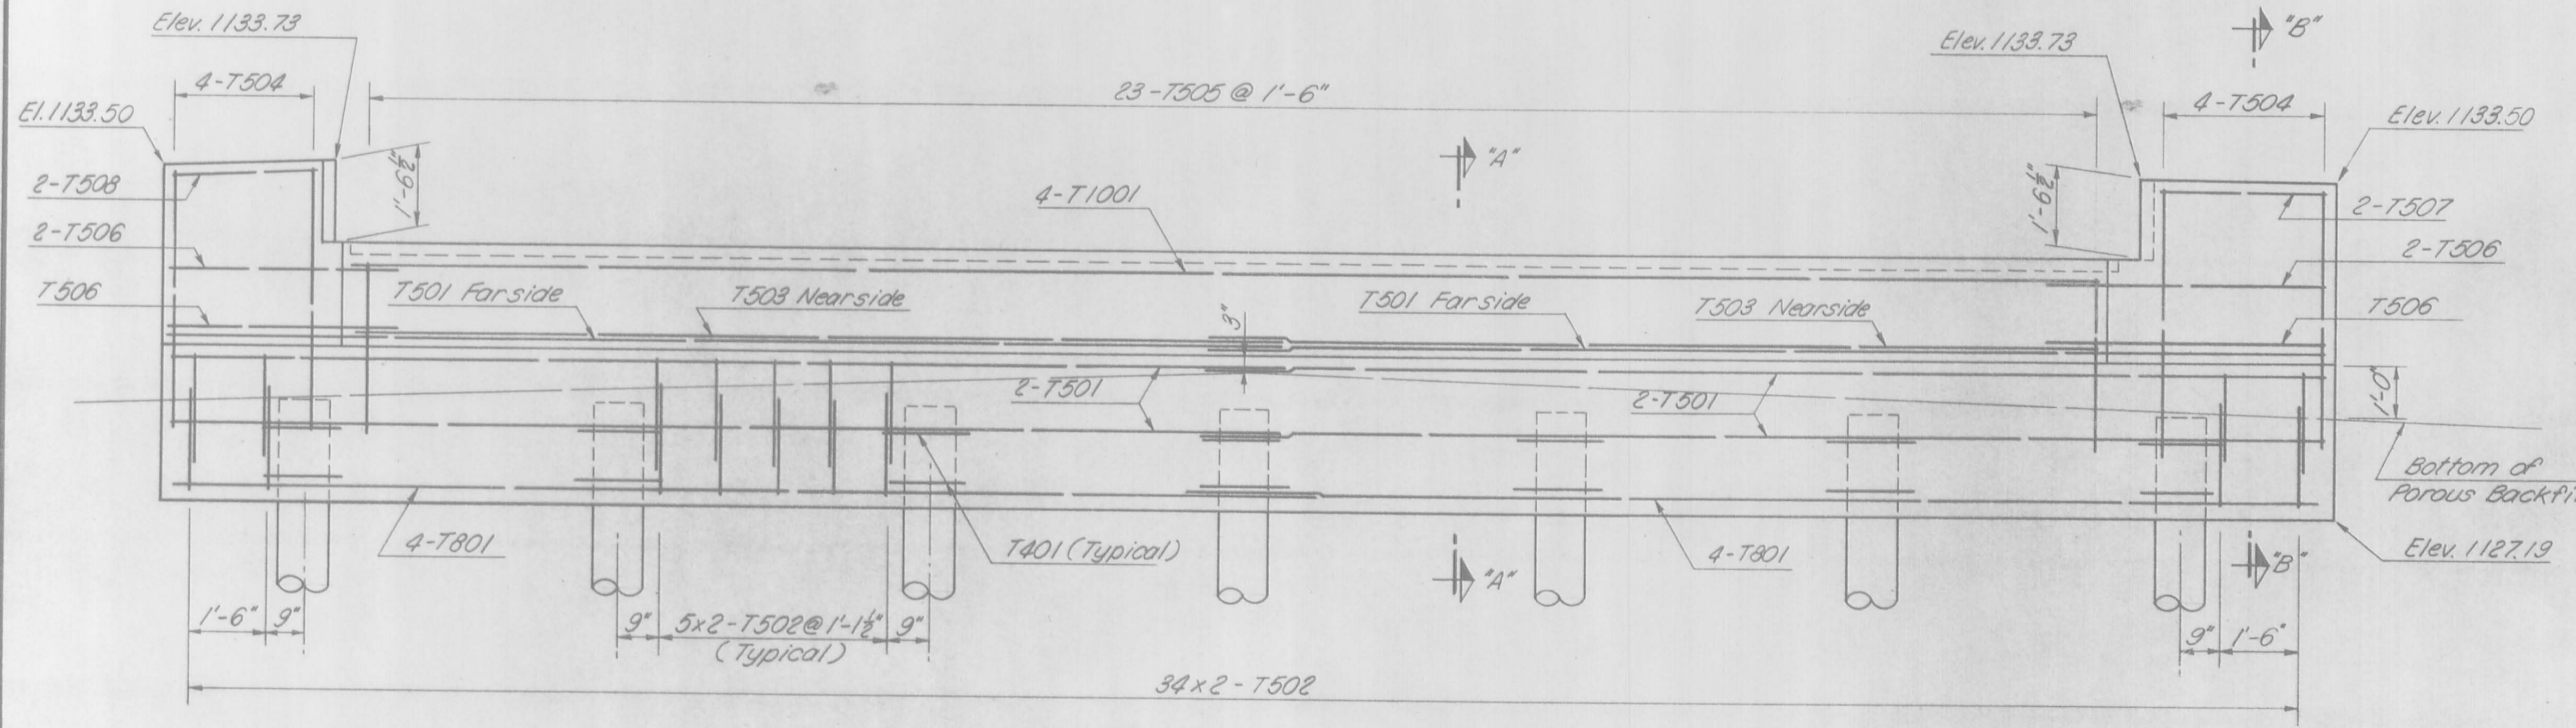


ELEVATION

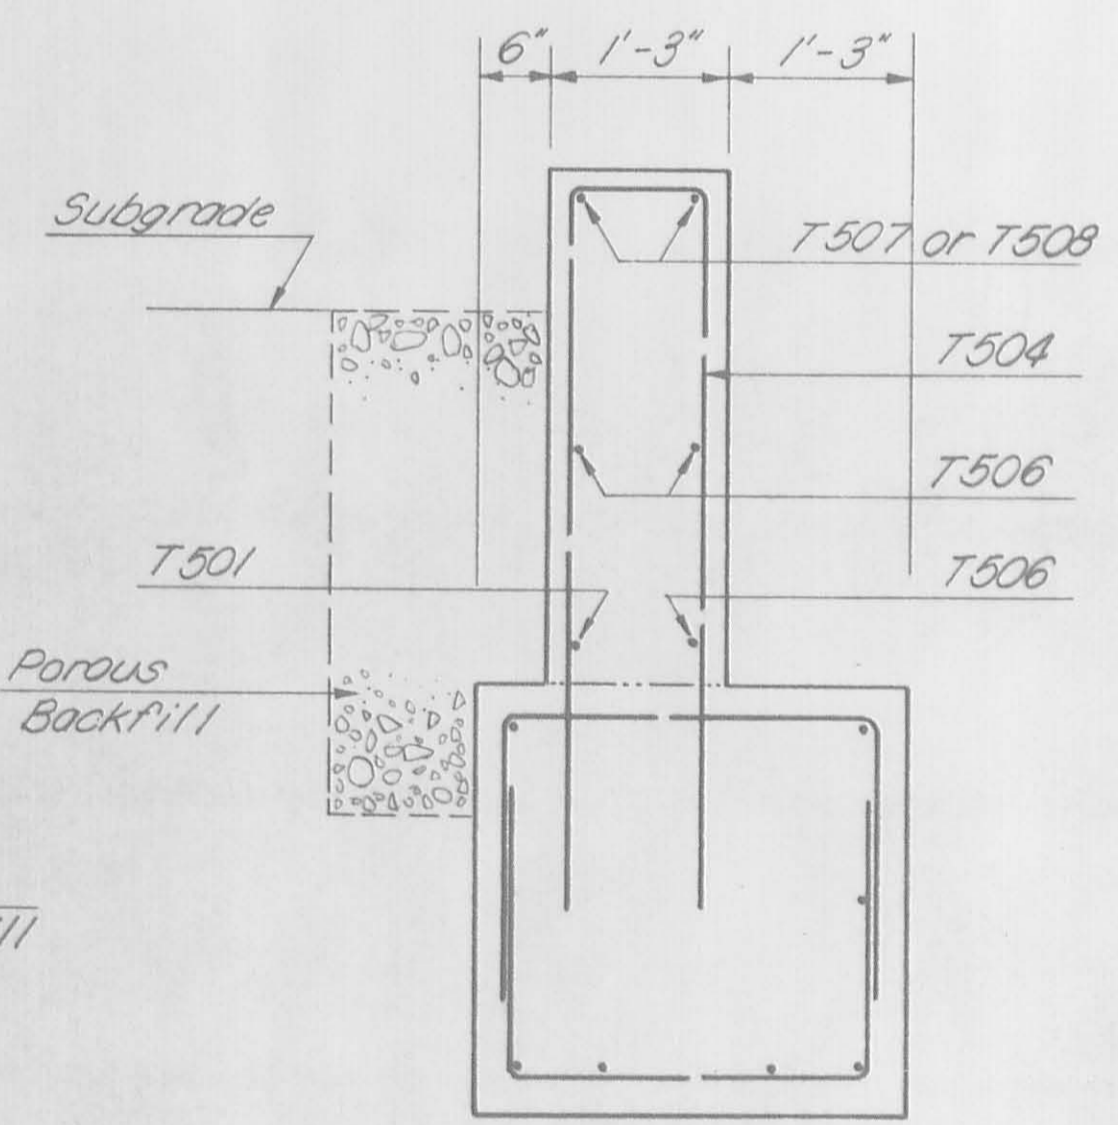


SECTION "B-B"

POROUS BACKFILL shall extend upward to the plane of the Subgrade and laterally to the surface of the embankment slopes.


| | | | | | |
|--|-------|---------|----------|---------|---------|
| ERIKSSON ENGINEERING COLUMBUS OHIO | | | | | |
| ABUTMENT NO. 1 | | | | | |
| BRIDGE NO. 29-2.70 CH. 29 OVER MAD RIVER | | | | | |
| LOGAN COUNTY, STA. 3+12.00 TO STA. 4+20.09 | | | | | |
| Designed | Drawn | Checked | Reviewed | Date | Revised |
| V.K. | G.S. | lbb | | 5-20-75 | |

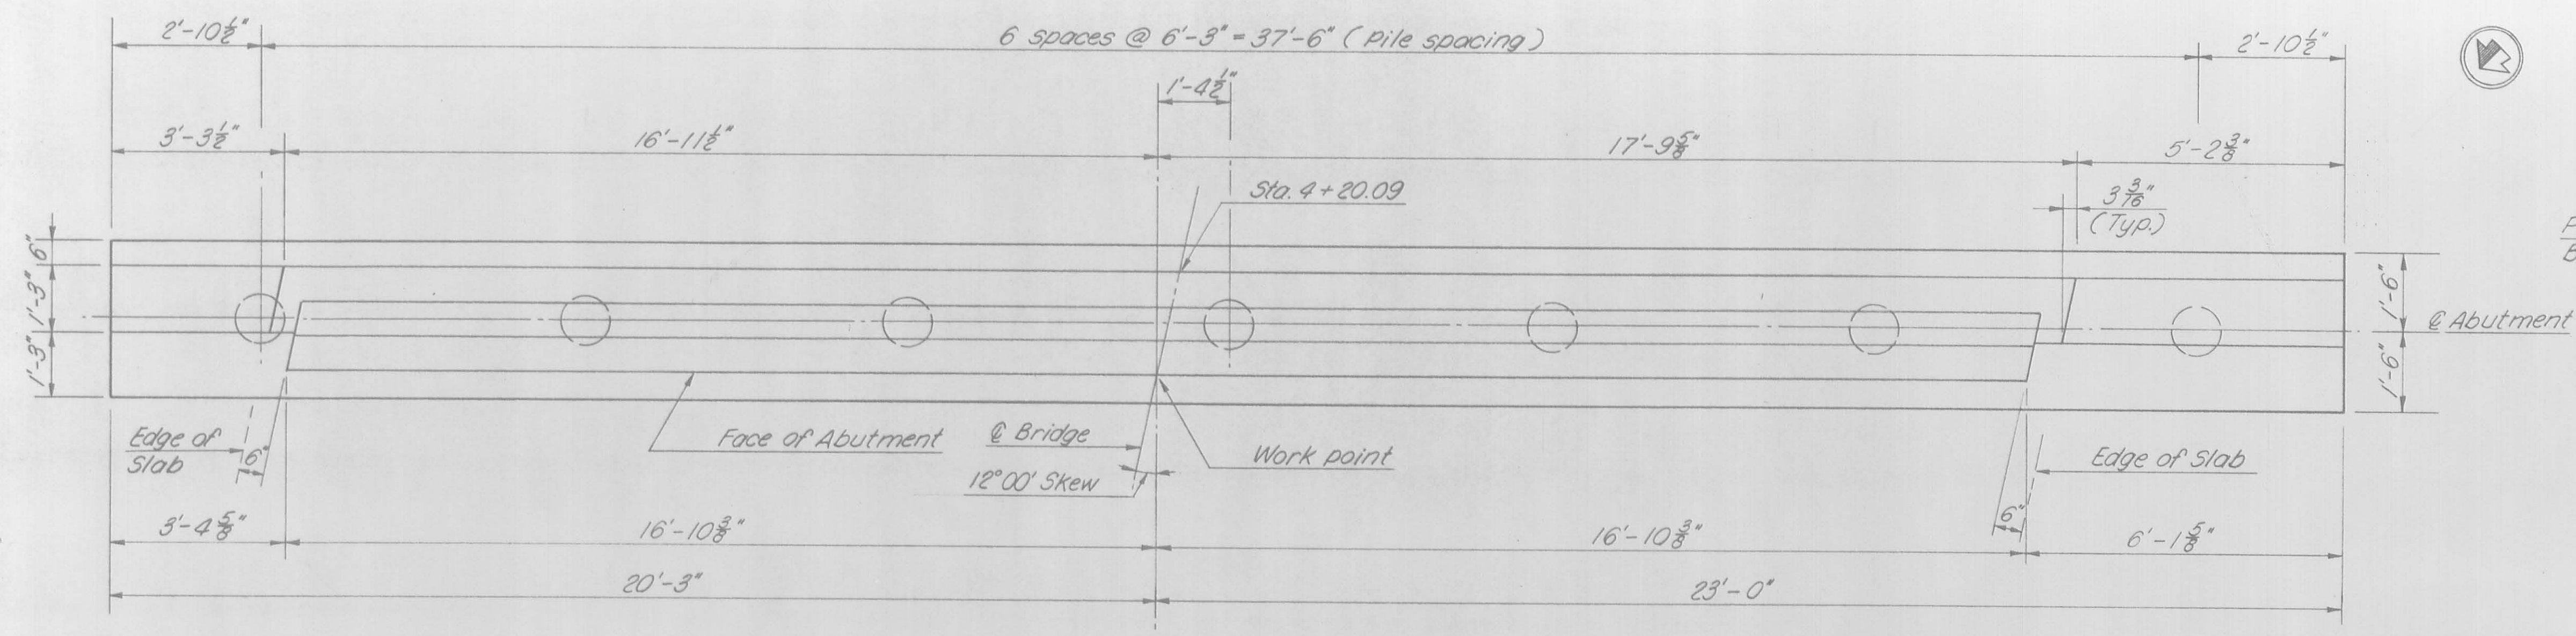


PLAN

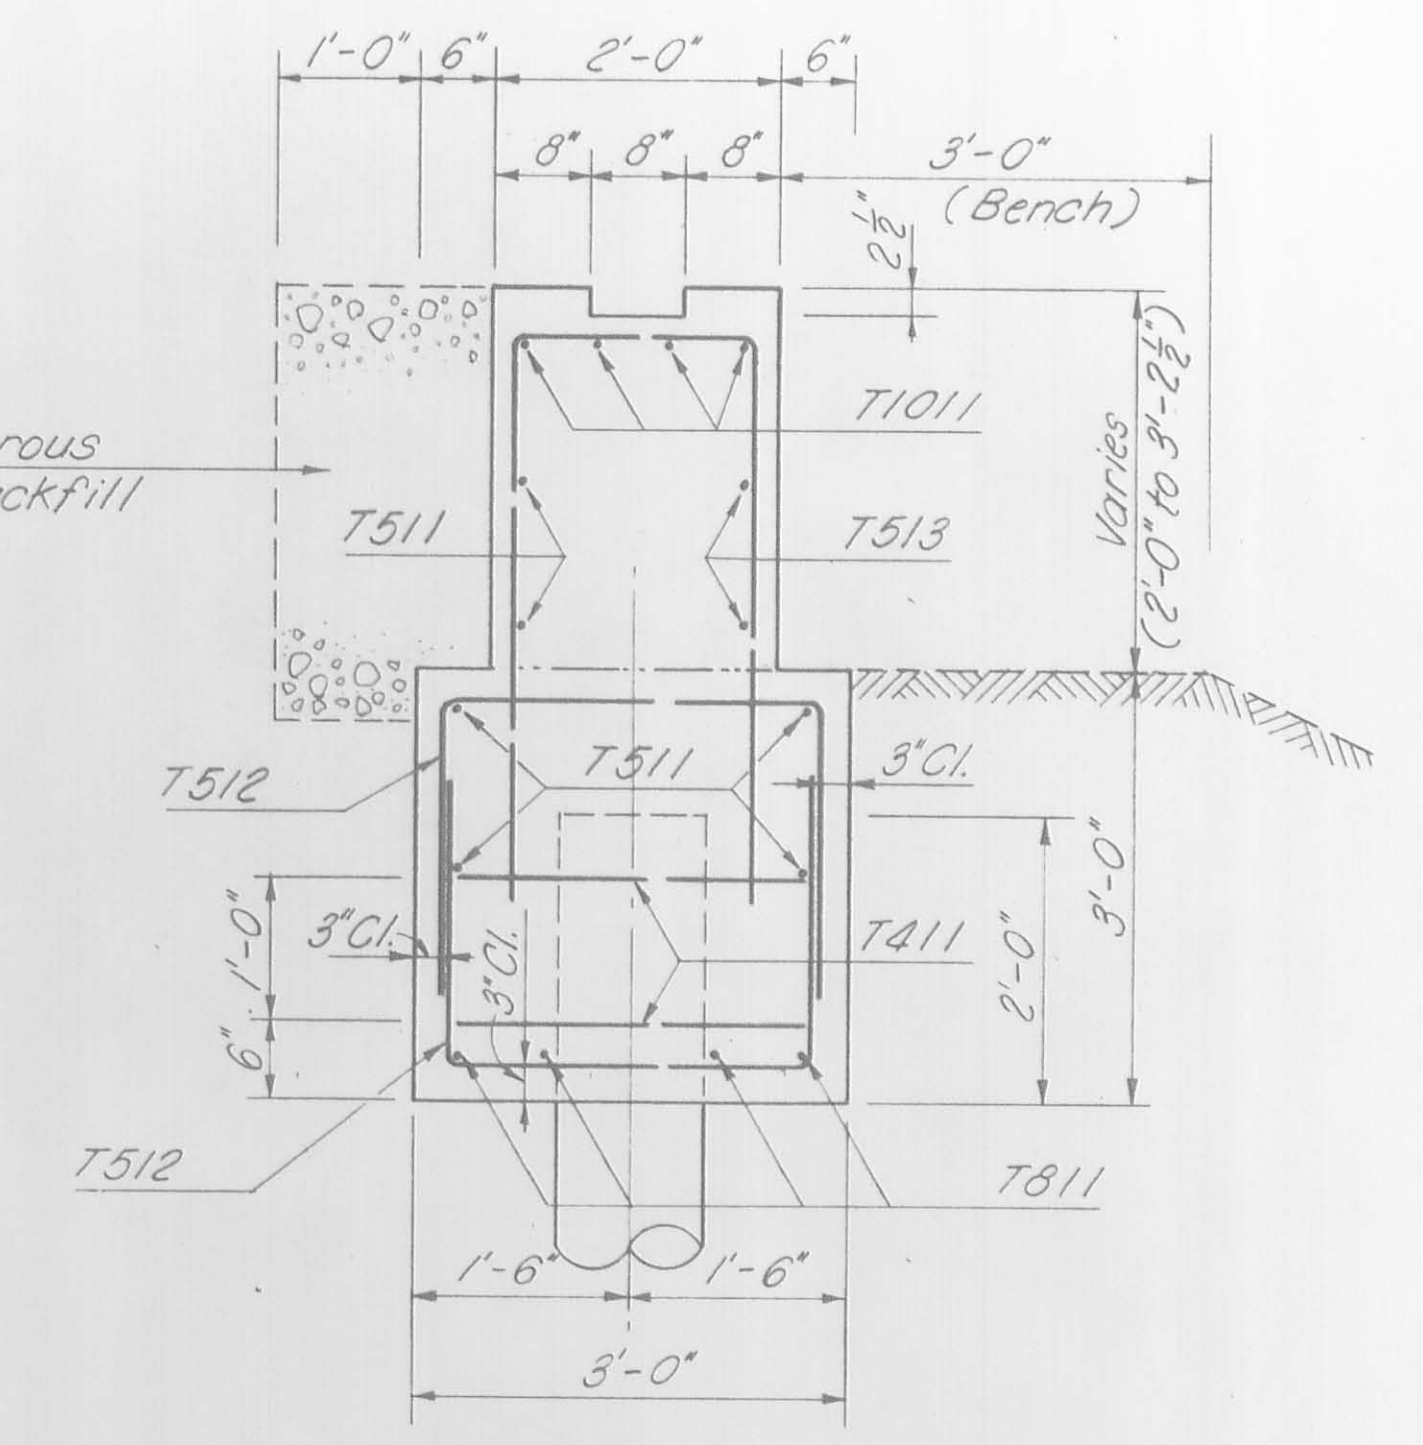

SECTION "A-A"

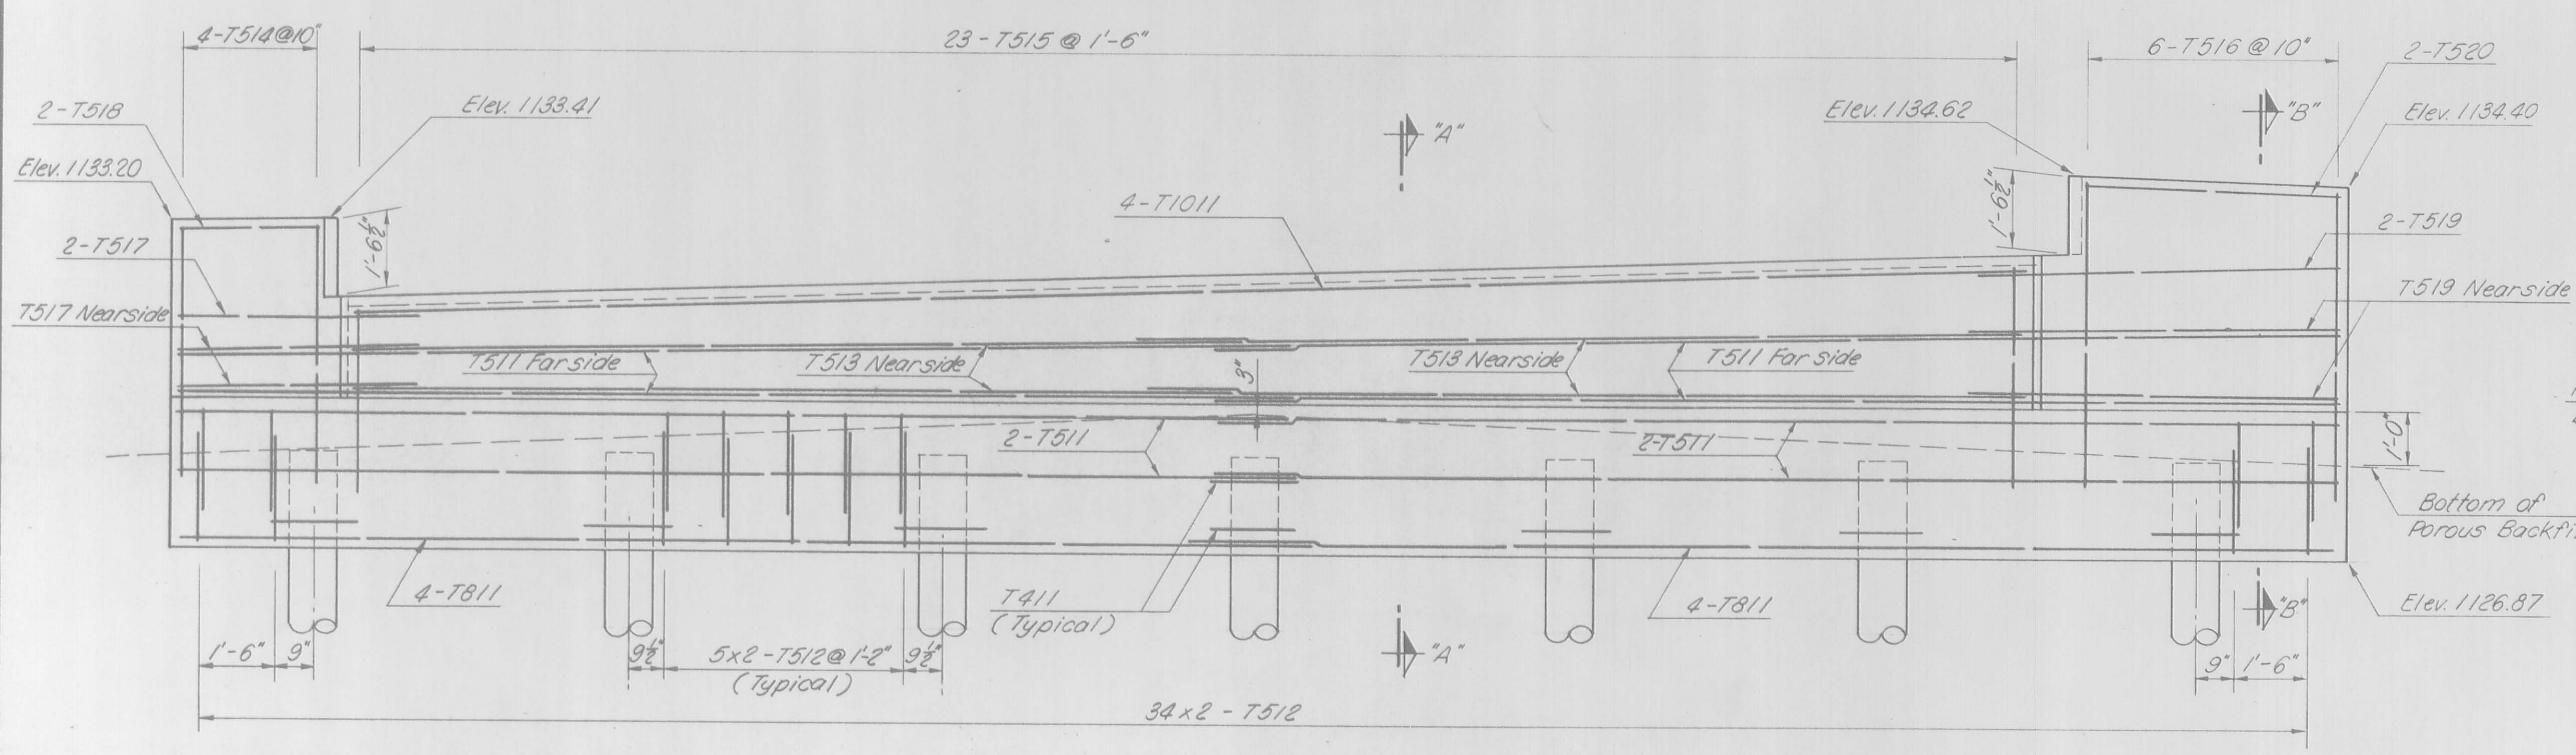


ELEVATION

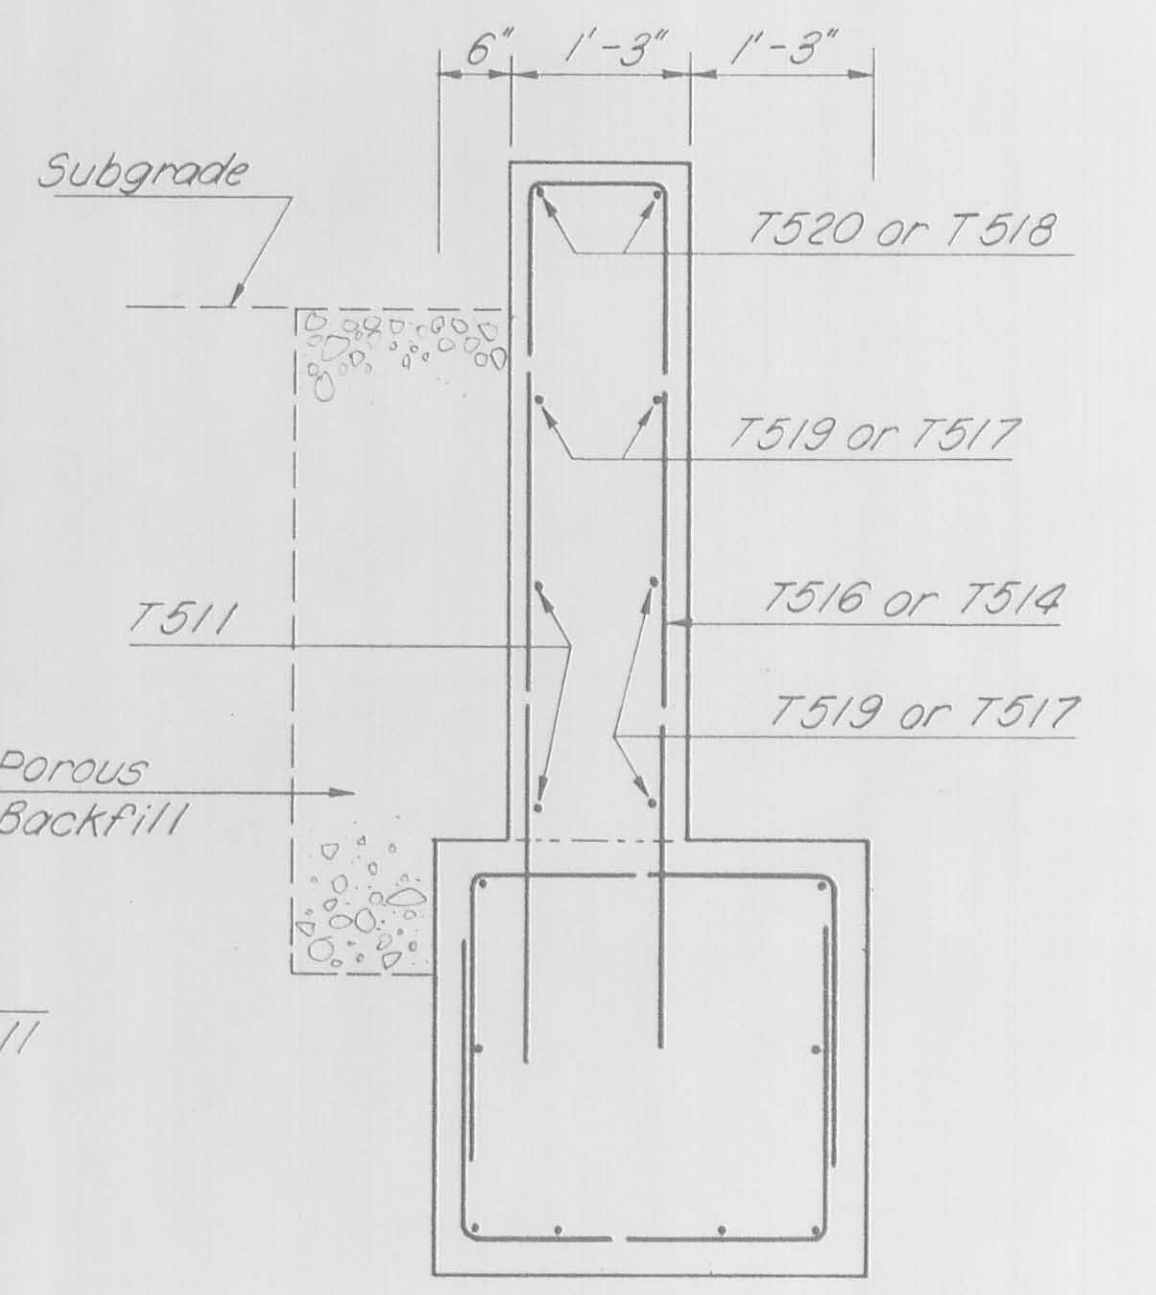


SECTION B-B

POROUS BACKFILL shall extend upward to the plane of the Subgrade and laterally to the surface of the embankment slopes.


| | | | | | |
|--|-------|---------|----------|---------|---------|
| ERIKSSON ENGINEERING COLUMBUS OHIO | | | | | |
| ABUTMENT NO. 2 | | | | | |
| BRIDGE NO. 29-2.70 C.H. 29 OVER MAD RIVER | | | | | |
| LOGAN COUNTY, STA. 3+12.00 TO STA. 4+20.09 | | | | | |
| Designed | Drawn | Checked | Reviewed | Date | Revised |
| V.K. | G.S. | lll | | 5-20-75 | |

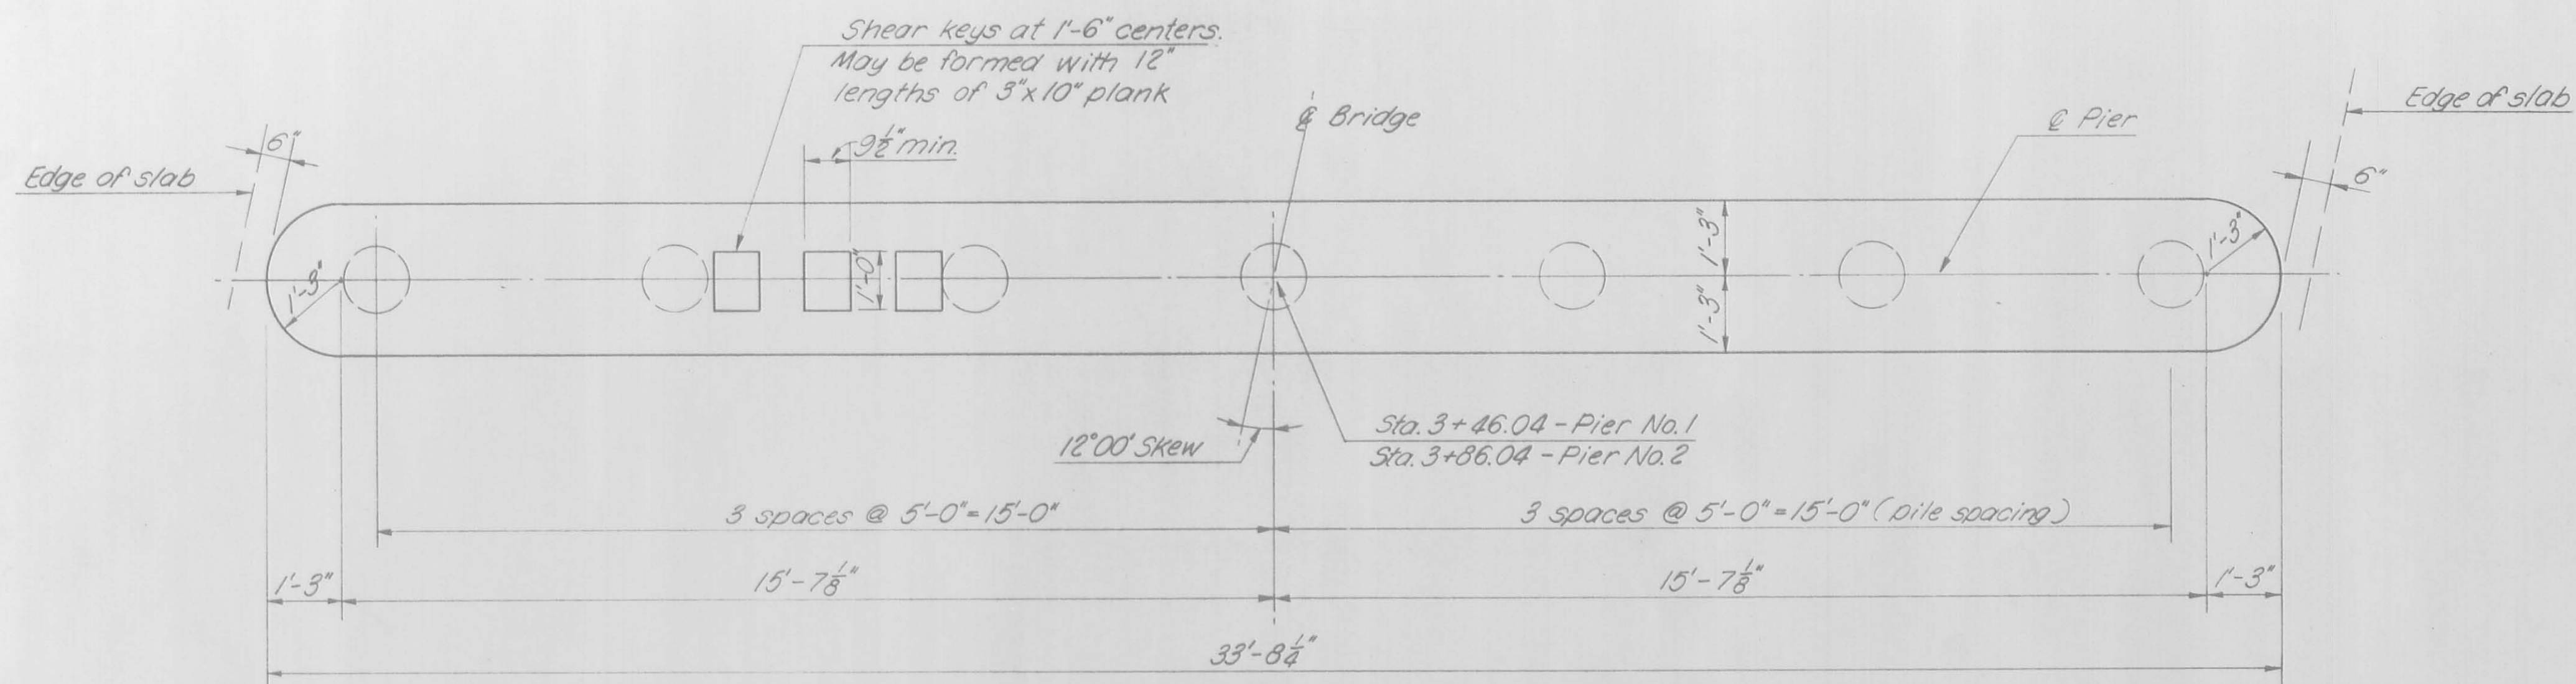

PLAN

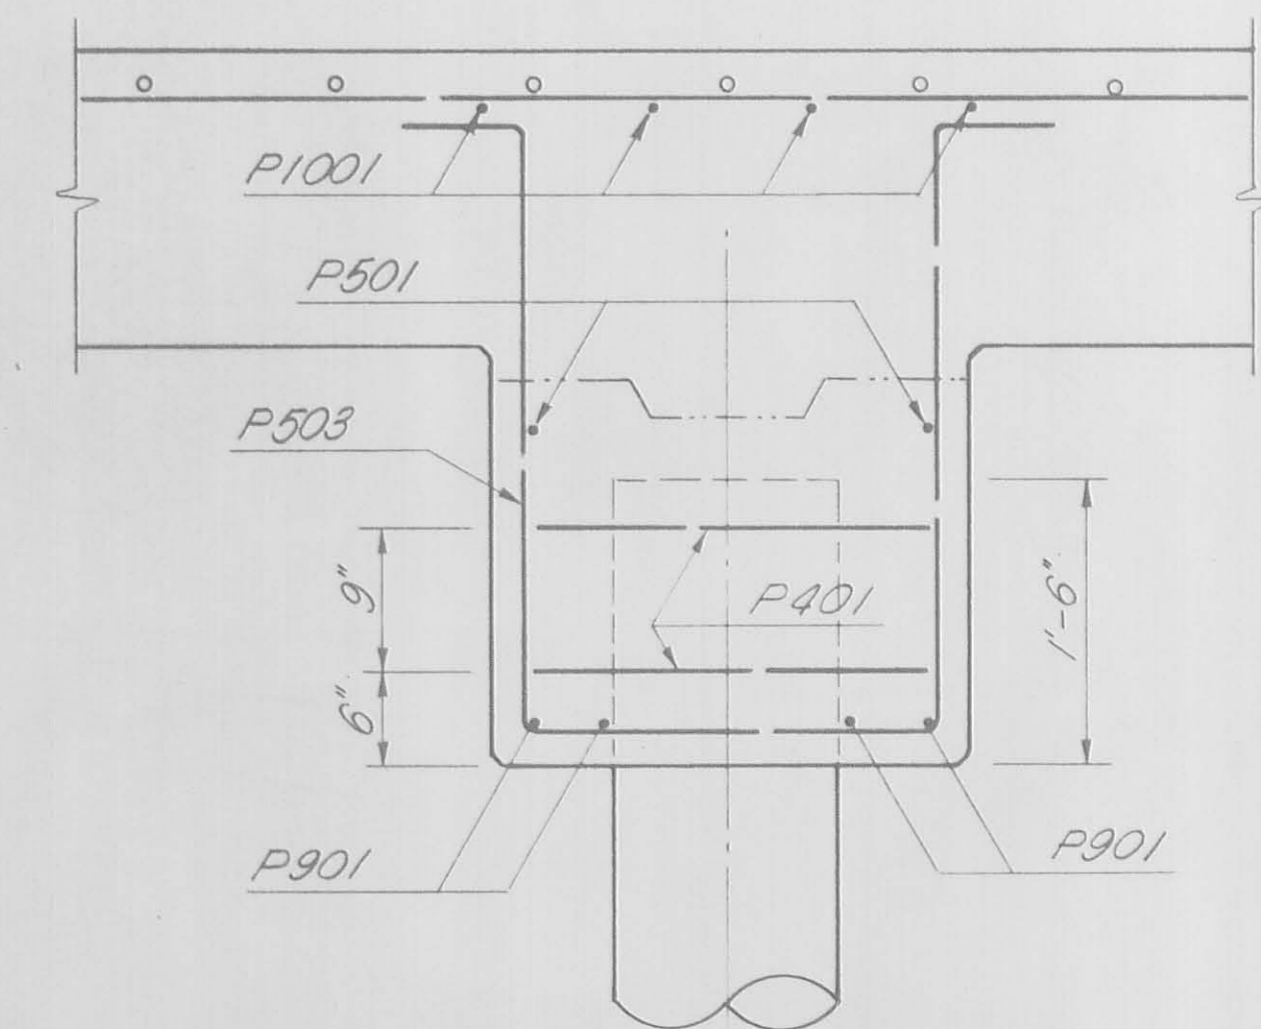



SECTION "A-A"

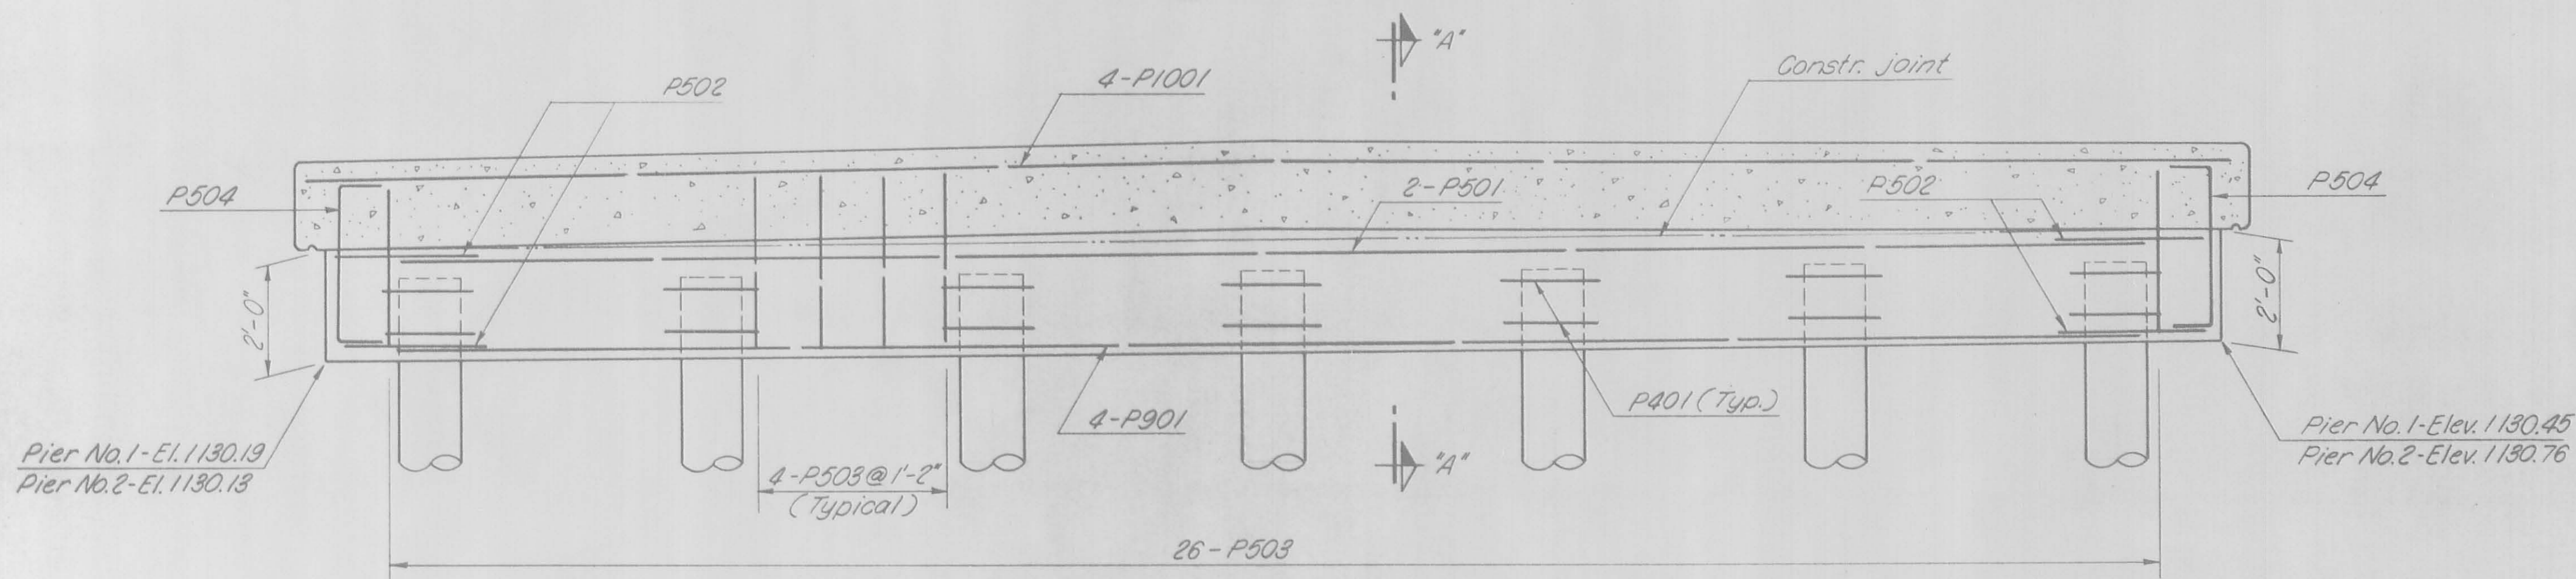


ELEVATION

FALSEWORK SUPPORT: Attachment of falsework support members to pier piles will be permitted, if the attachment is made to that portion of pile encased in the pier cap.

| | | | | | |
|--|-------|---------|----------|---------|---------|
| ERIKSSON ENGINEERING COLUMBUS OHIO | | | | | |
| PIERS | | | | | |
| BRIDGE NO. 29-2.70 C.H. 29 OVER MAD RIVER | | | | | |
| LOGAN COUNTY, STA. 3+12.00 TO STA. 4+20.09 | | | | | |
| Designed | Drawn | Checked | Reviewed | Date | Revised |
| V.K. | G.S. | lll | | 5-20-75 | |

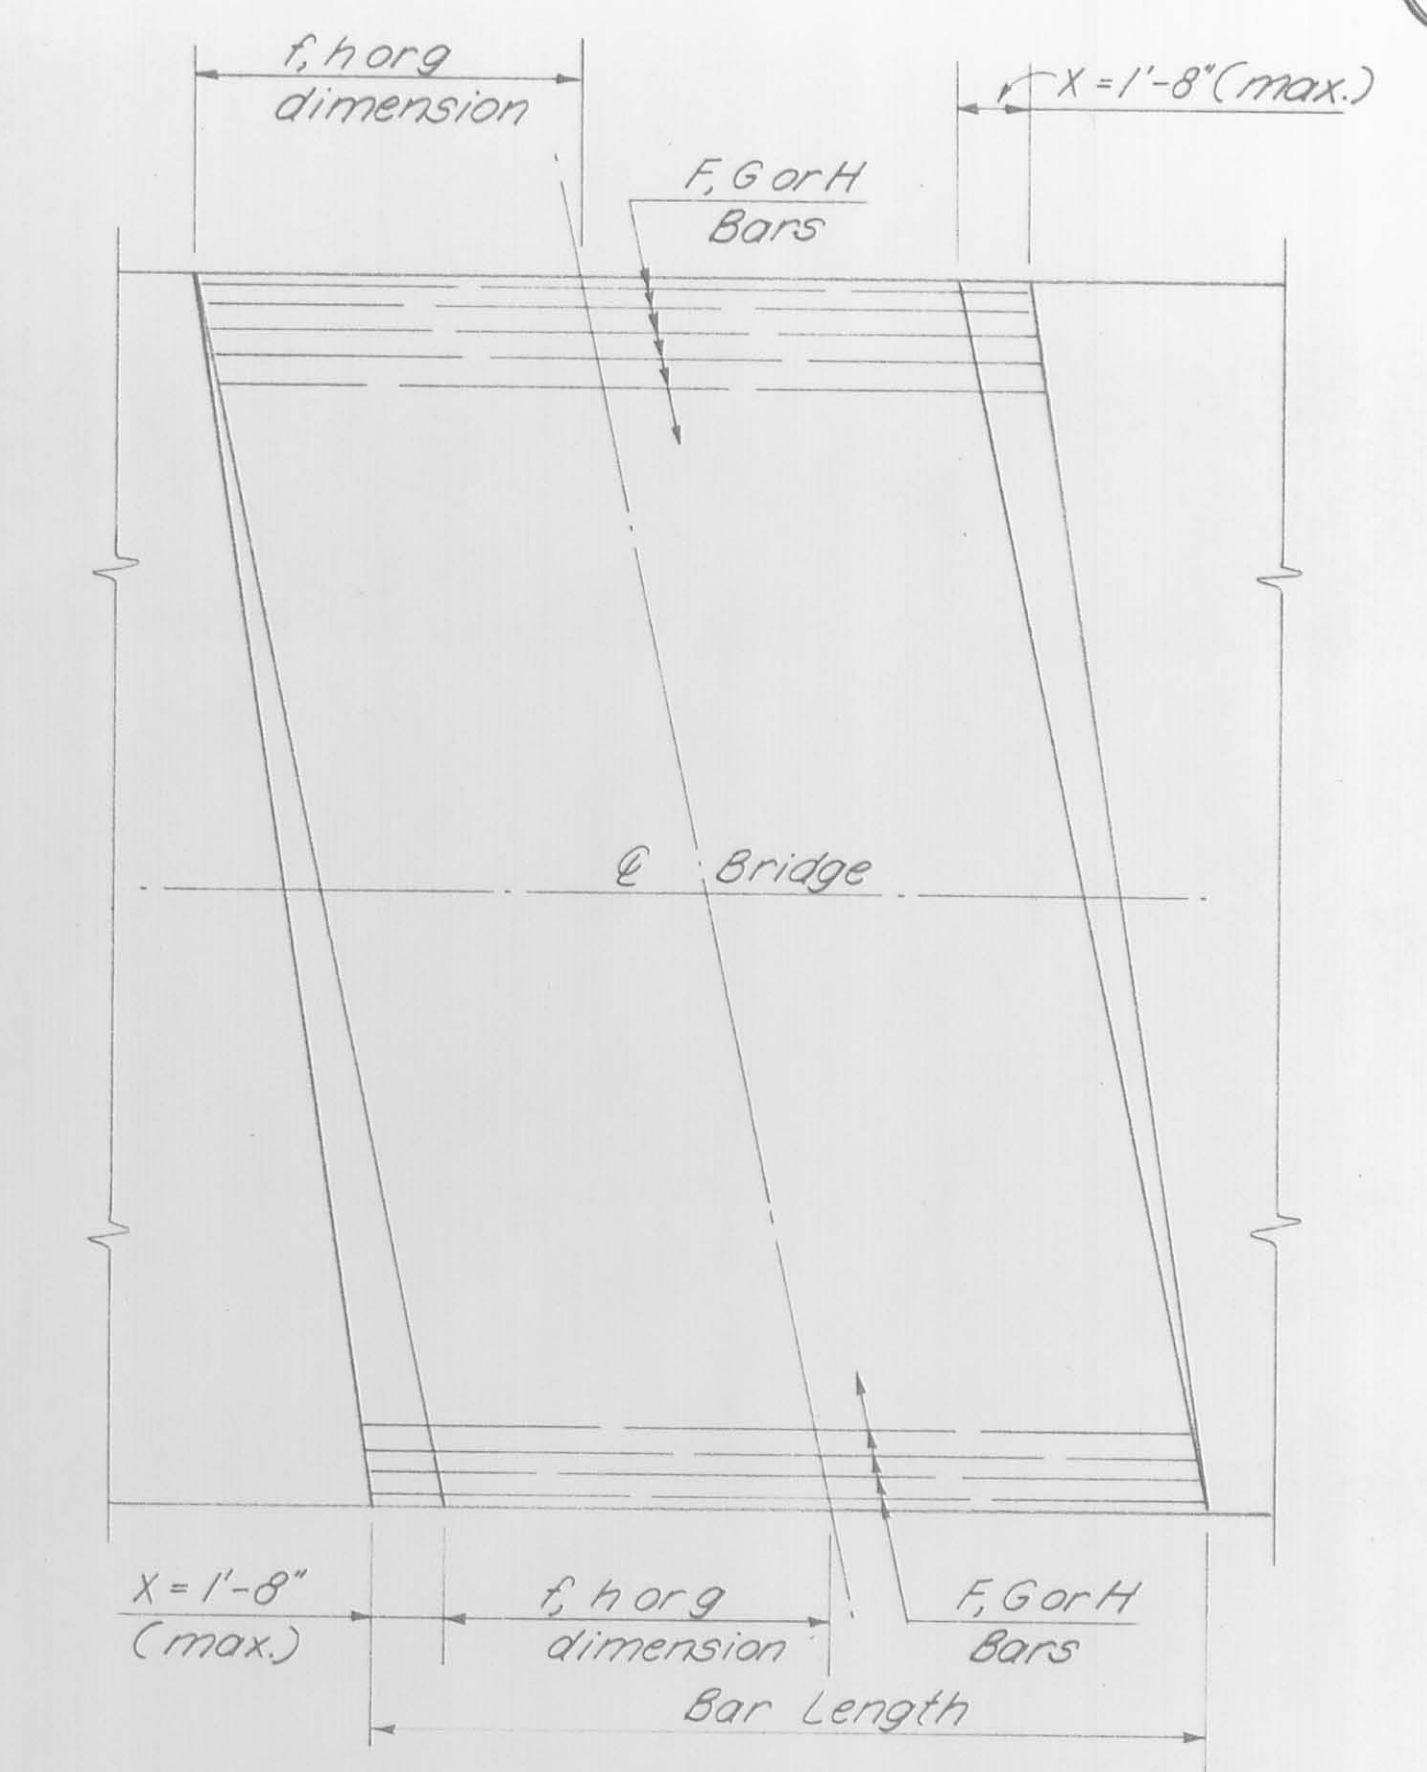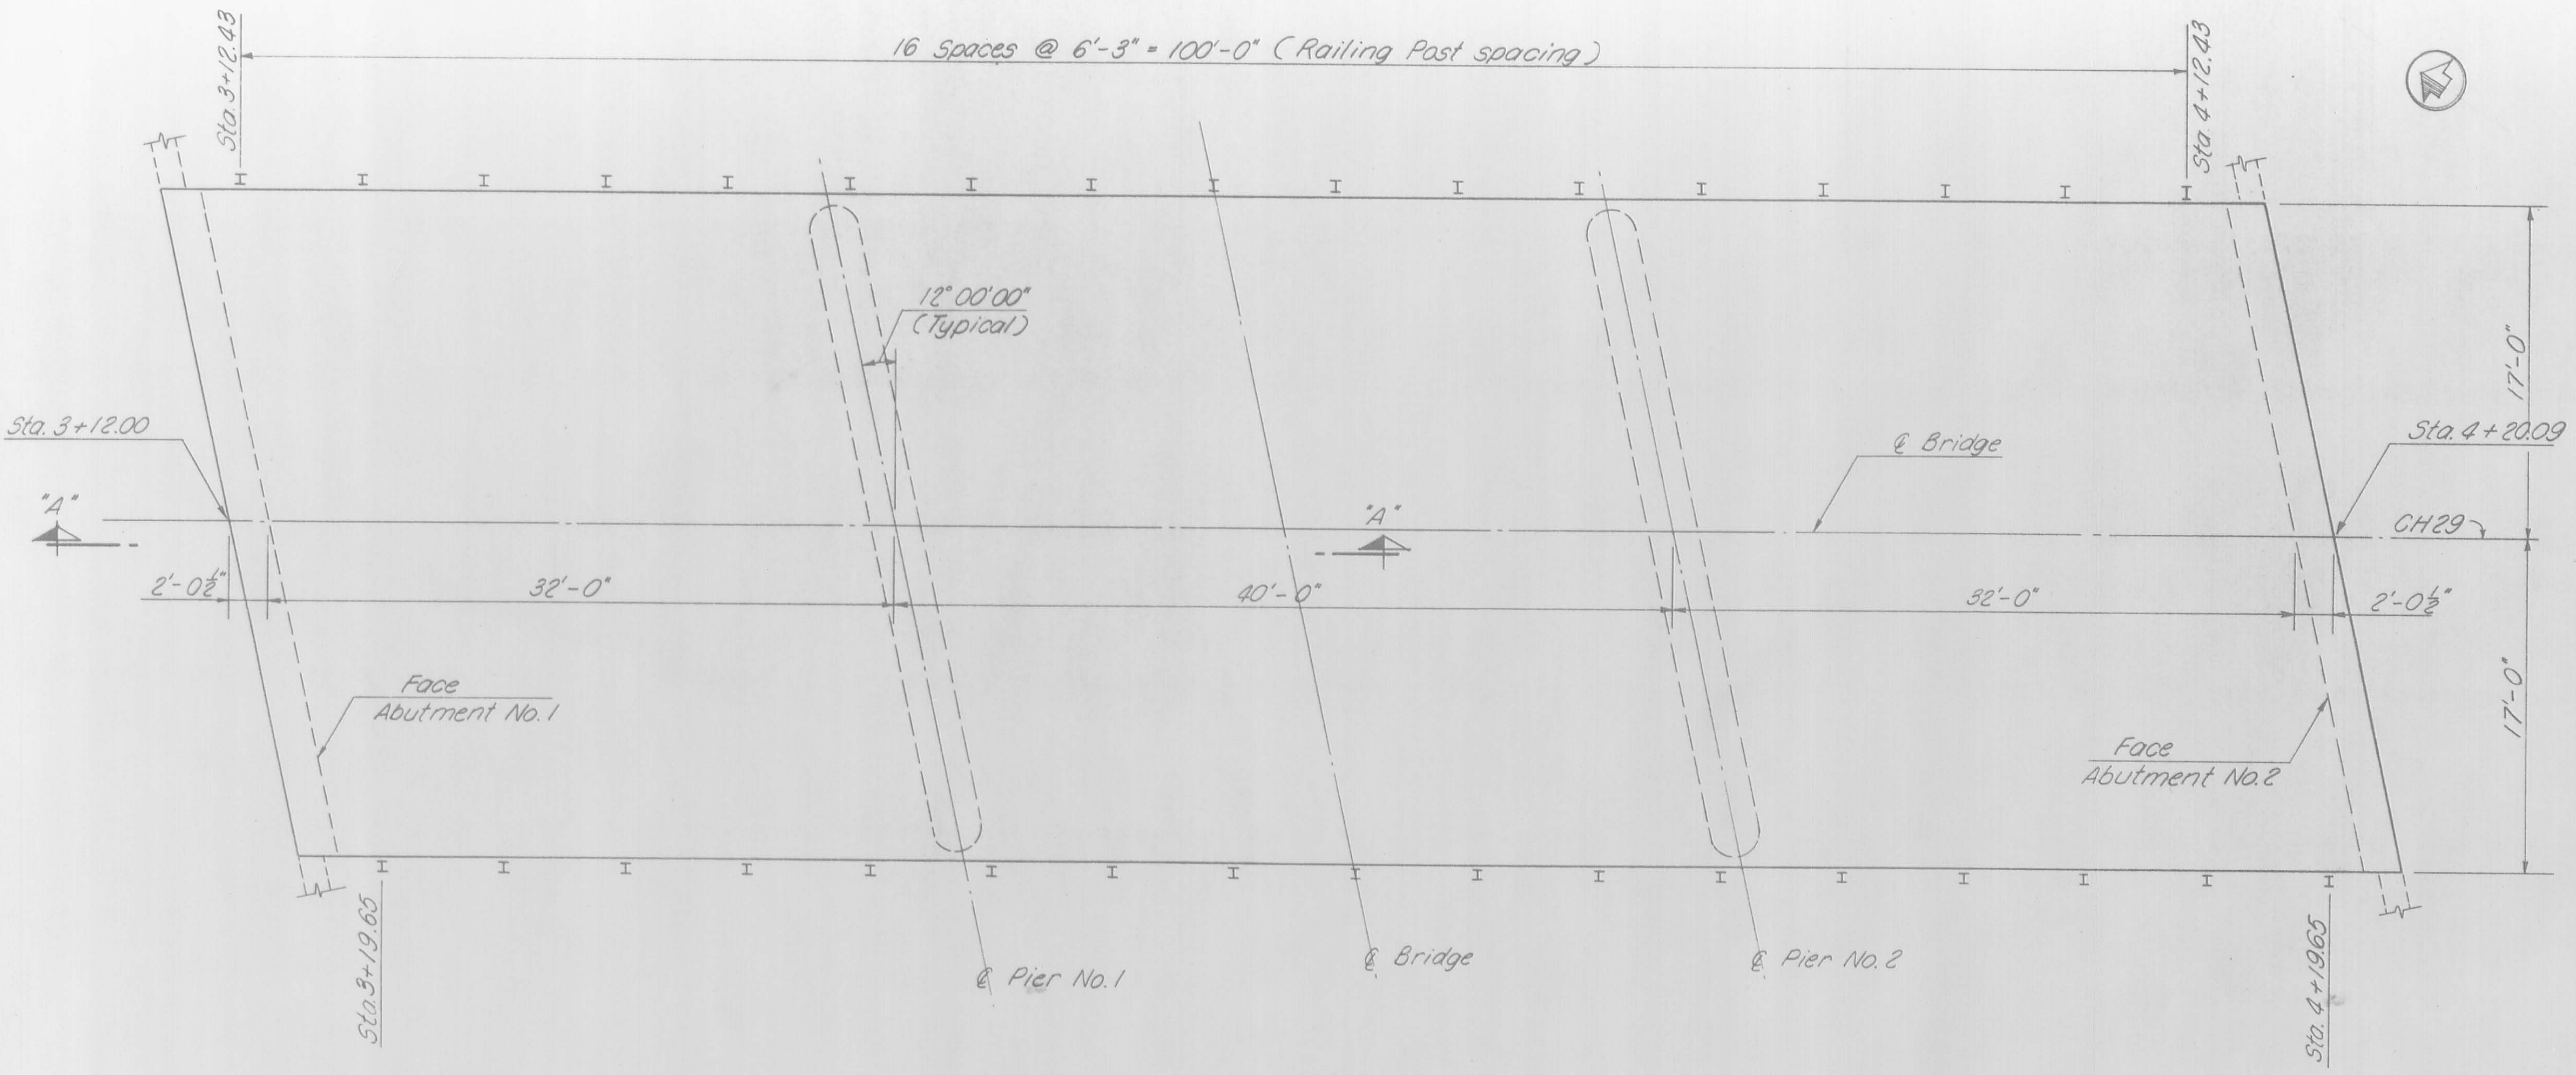

PLACEMENT DIAGRAM FOR F, G & H BARS

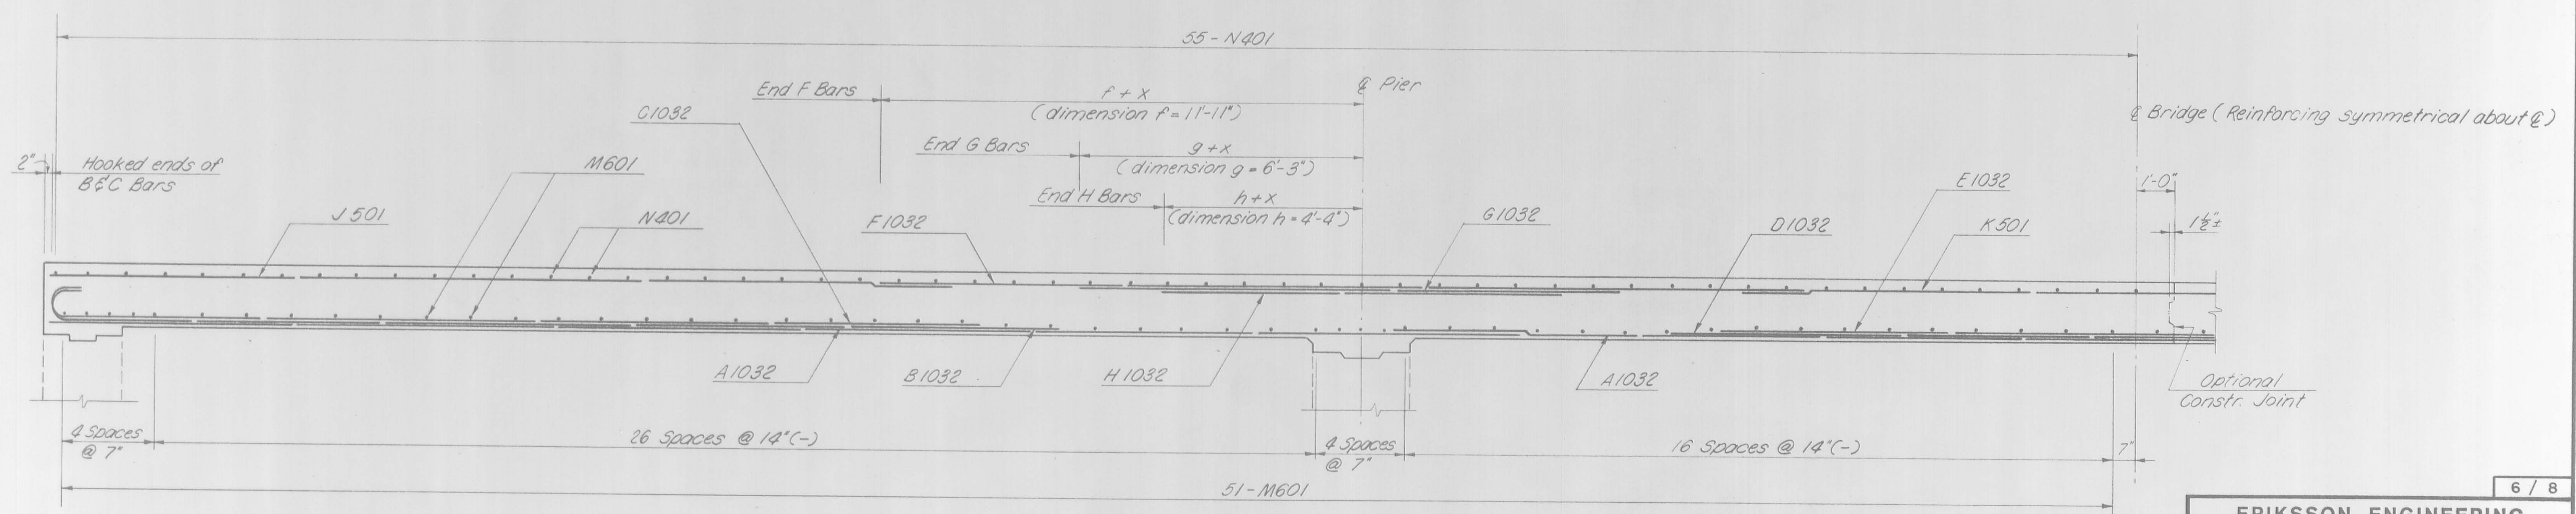

SECTION "A-A"

NOTE:
Camber of 1/800 of the span shall be provided in each span (in addition to that required for conformance with the profile of the highway) to allow for dead load deflection. This is the amount of camber required before falsework is released. To obtain this proper allowance shall be made for the deflection of falsework members.

6 / 8


ERIKSSON ENGINEERING
COLUMBUS OHIO

SUPERSTRUCTURE DETAILS

BRIDGE NO. 29-2.70
CH. 29 OVER MAD RIVER


LOGAN COUNTY, STA. 3+12.00 TO STA. 4+20.09

| Designed | Drawn | Checked | Reviewed | Date | Revised |
|----------|-------|---------|----------|---------|---------|
| V.K. | G.S. | lll | | 5-20-75 | |

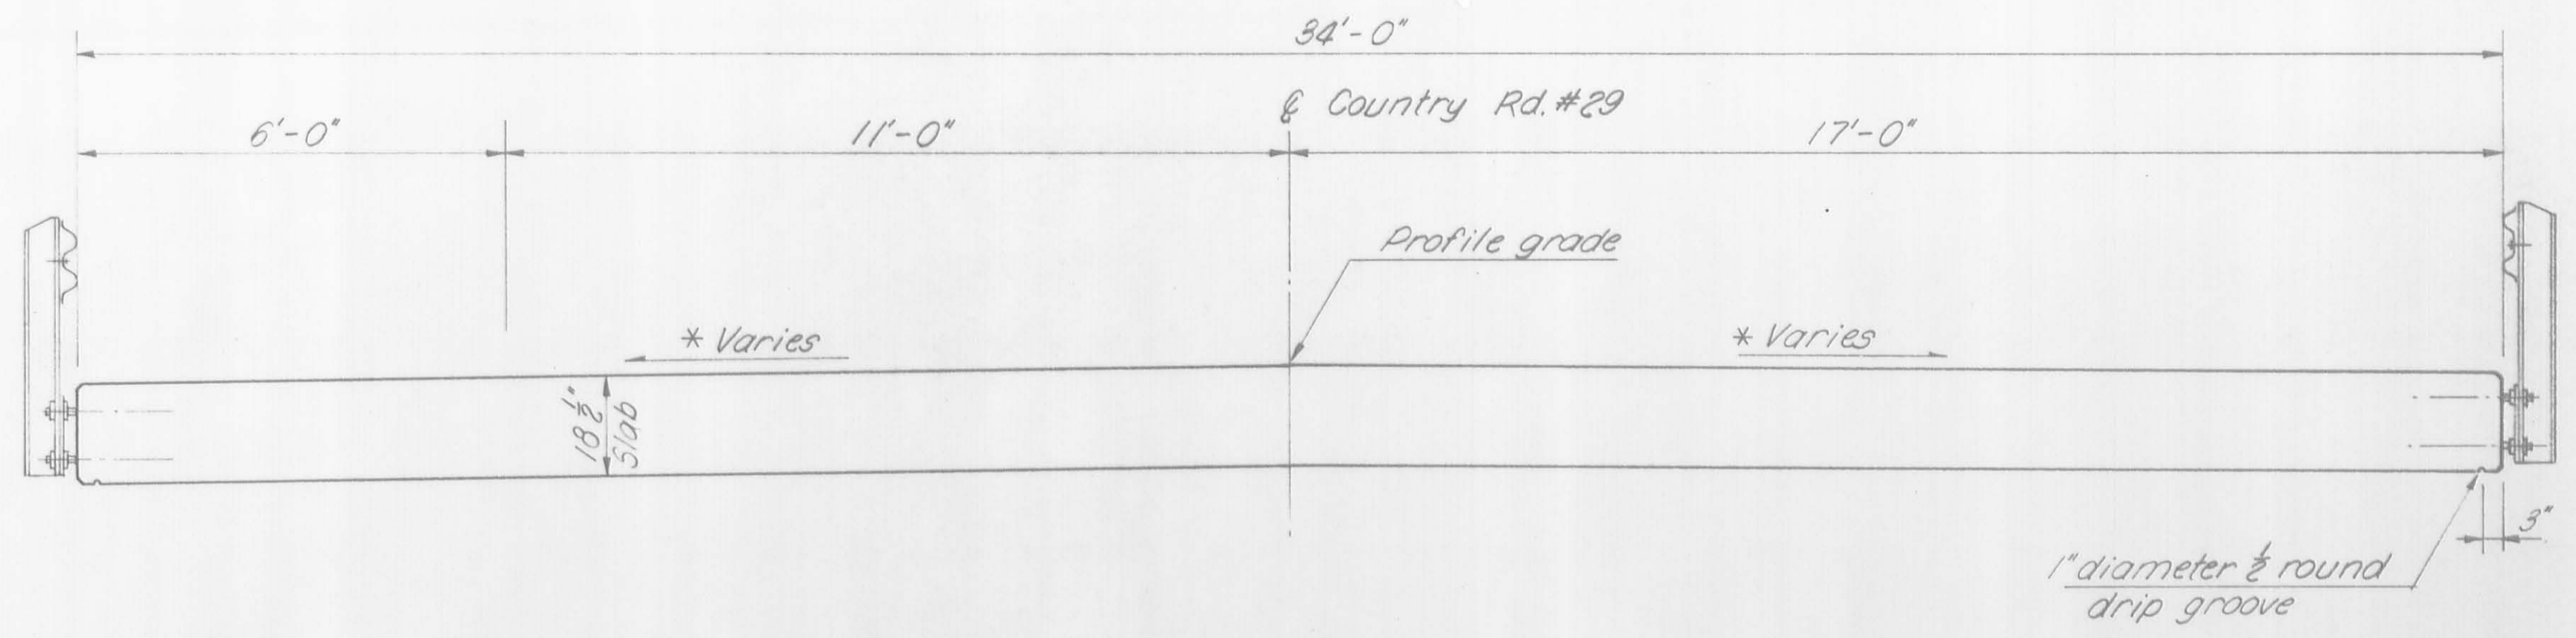


TYPICAL TRANSVERSE SECTION


* See "SUPERELEVATION DIAGRAM"

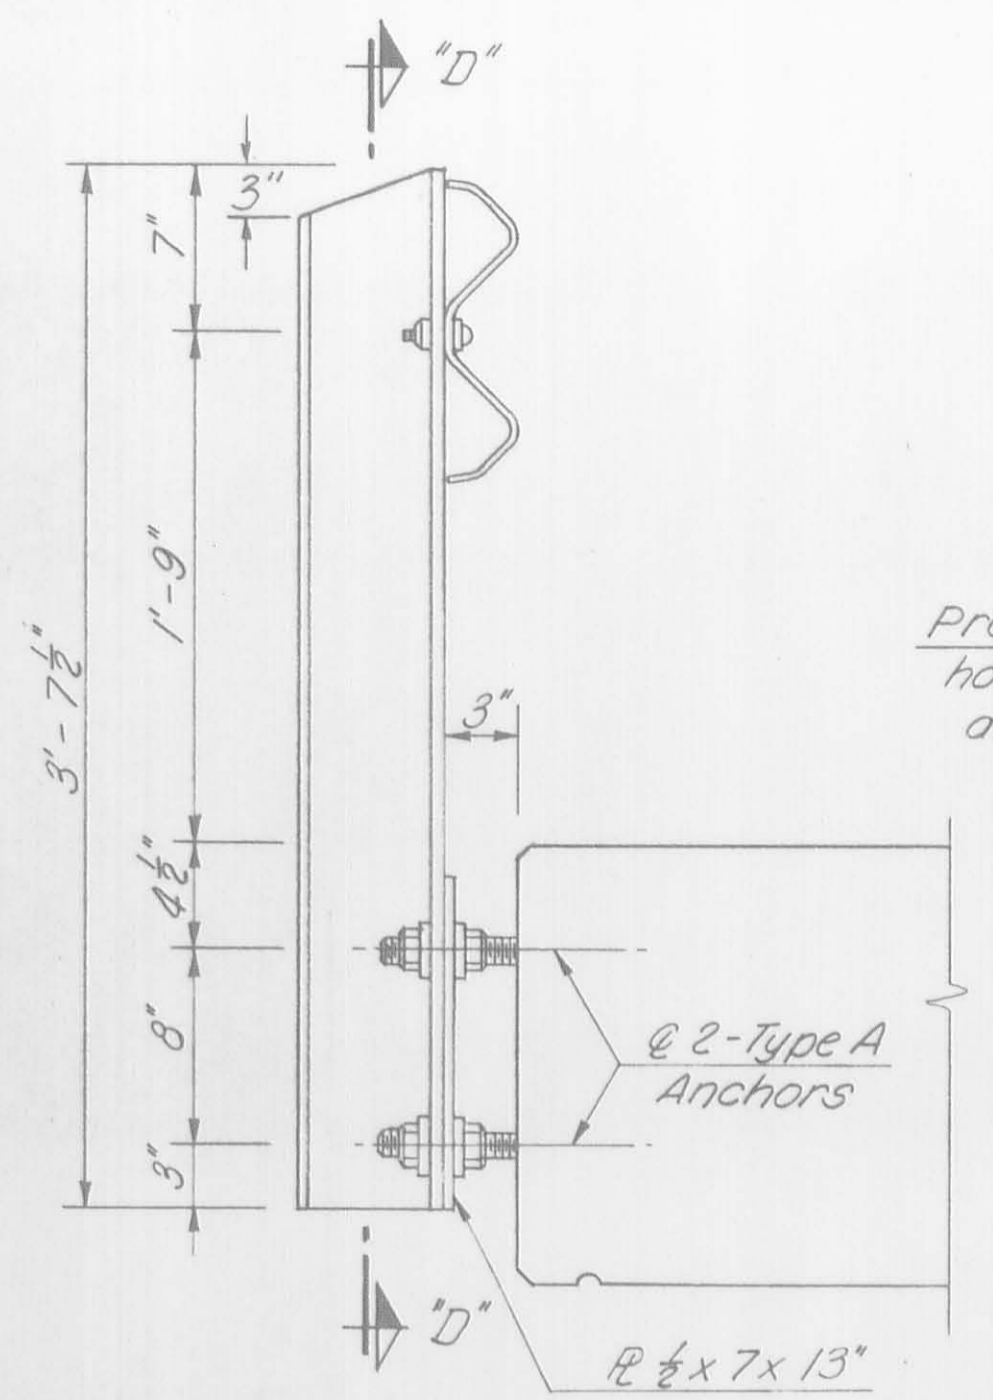


RAILING DETAILS

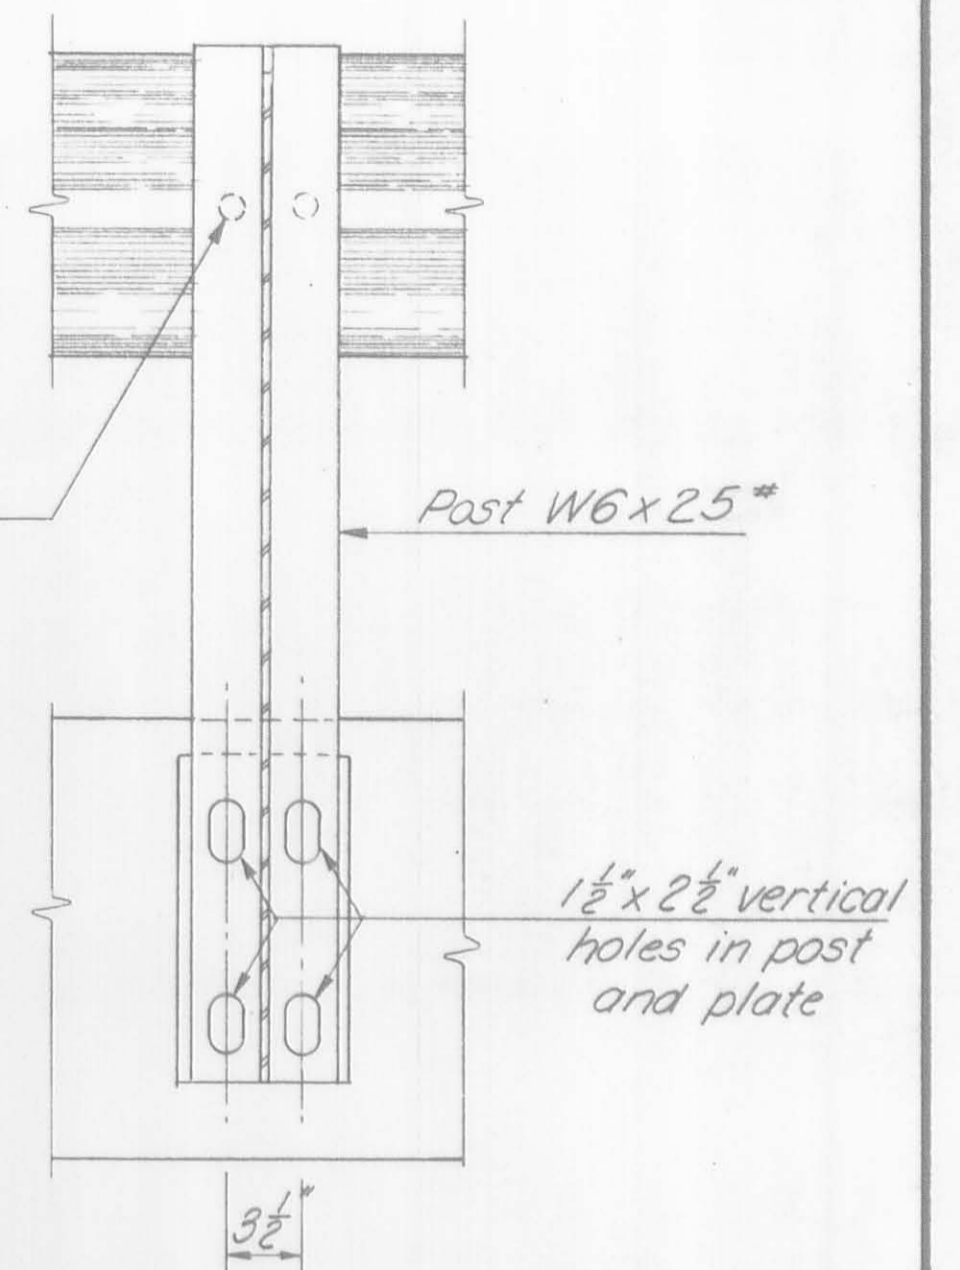

SECTION "D-D"

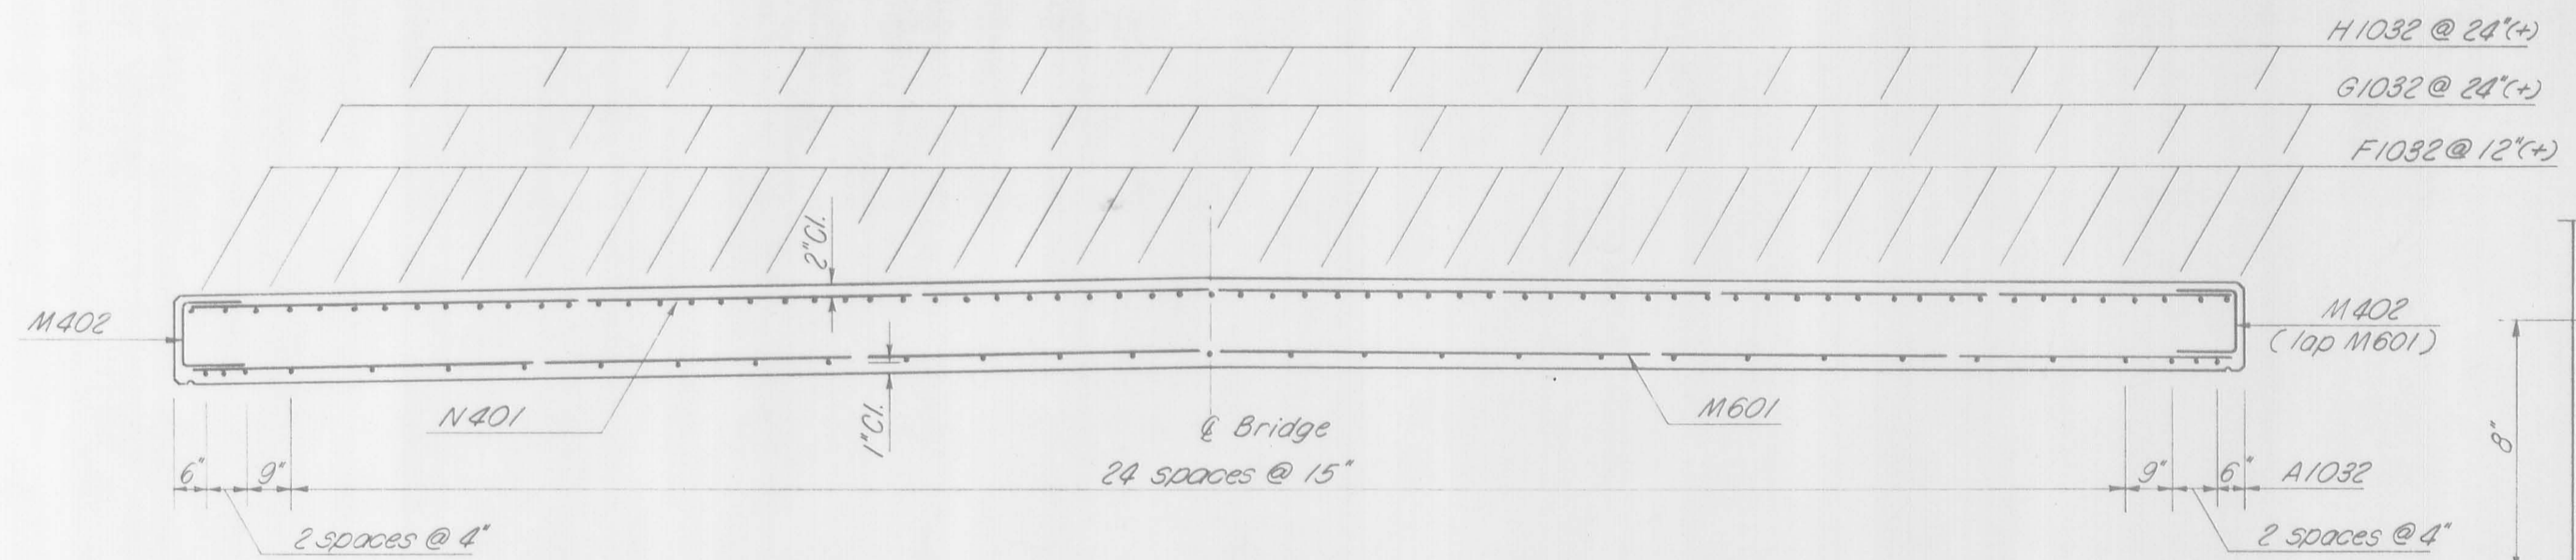


SECTION "B-B"
(at Piers)

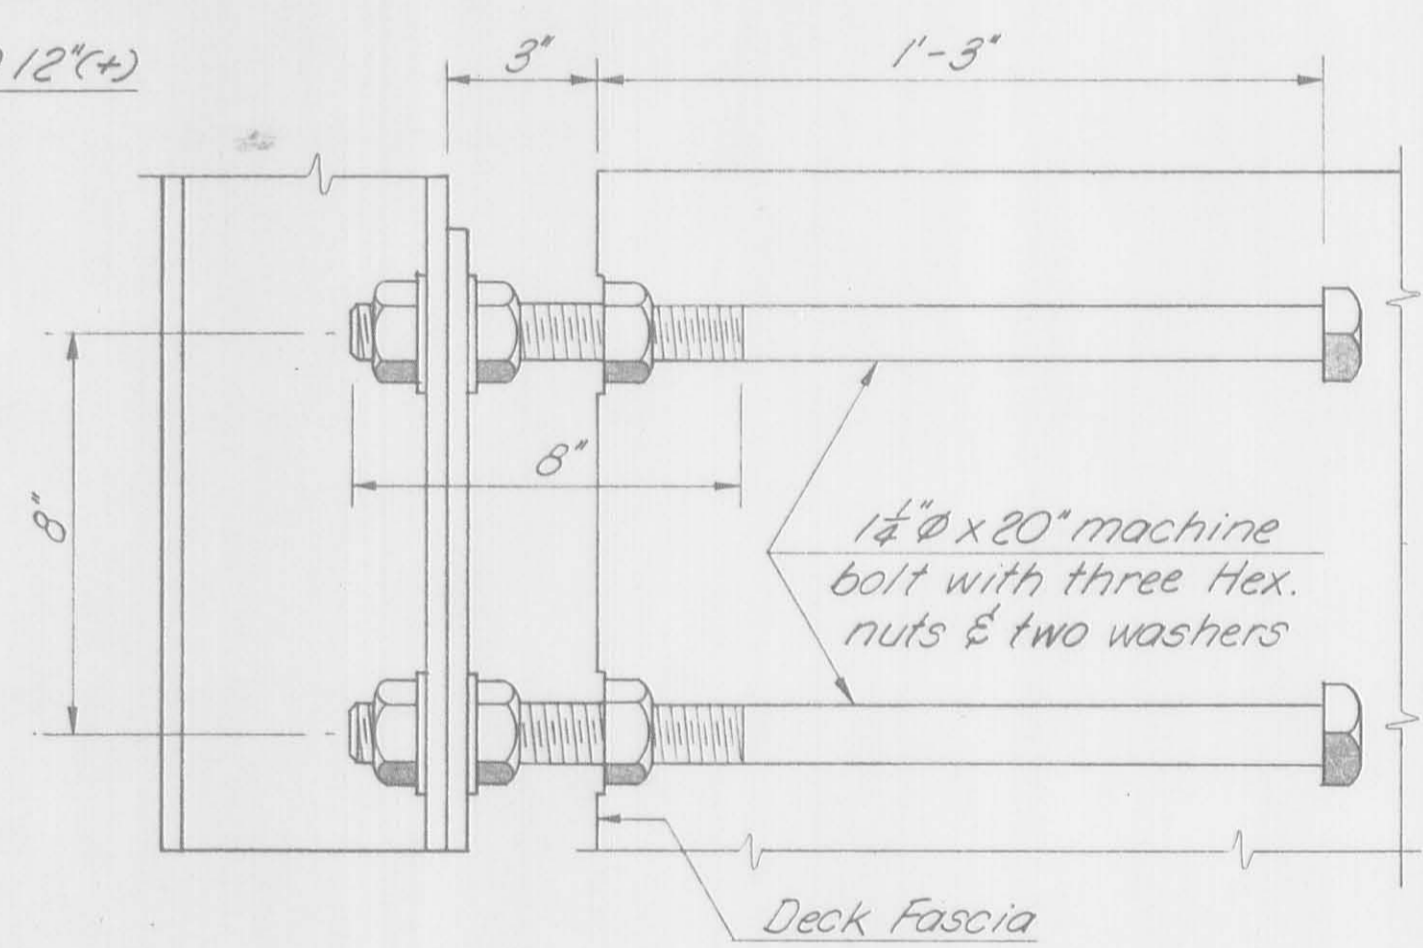


TYPE "A" ANCHOR DETAIL

NOTES

MATERIAL: All anchor bolts, nuts & studs shall conform to A.S.T.M. A325.
GALVANIZING: All metal parts of the railing including anchor bolts shall be galvanized in accordance with the latest requirements of A.S.T.M. A123 and A.S.T.M. A153 after fabrication.

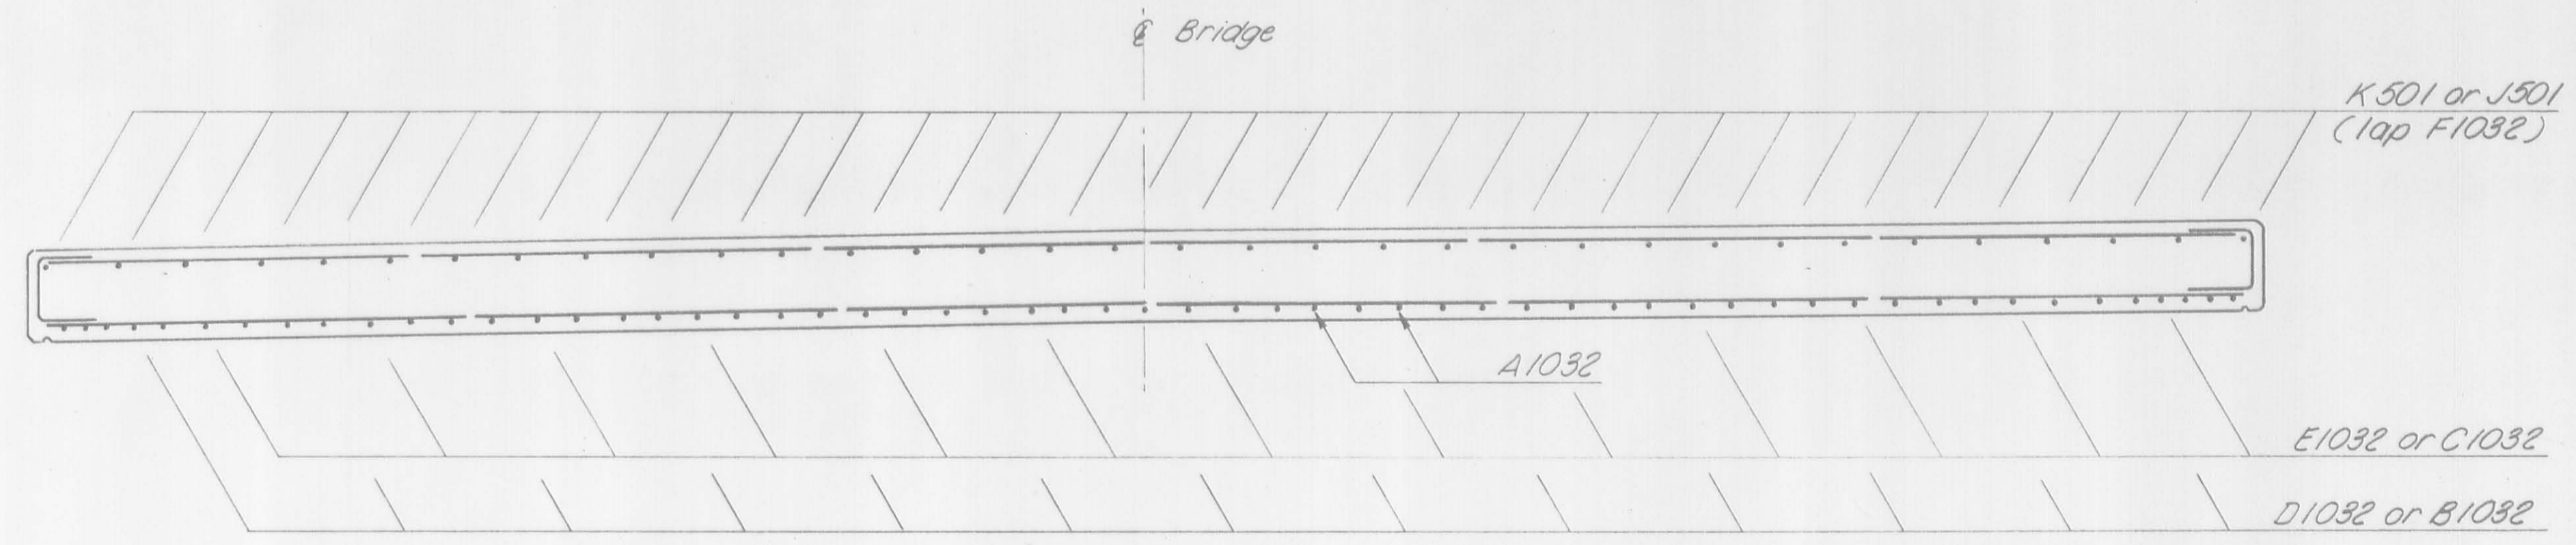


SECTION "C-C"
(at midspan)

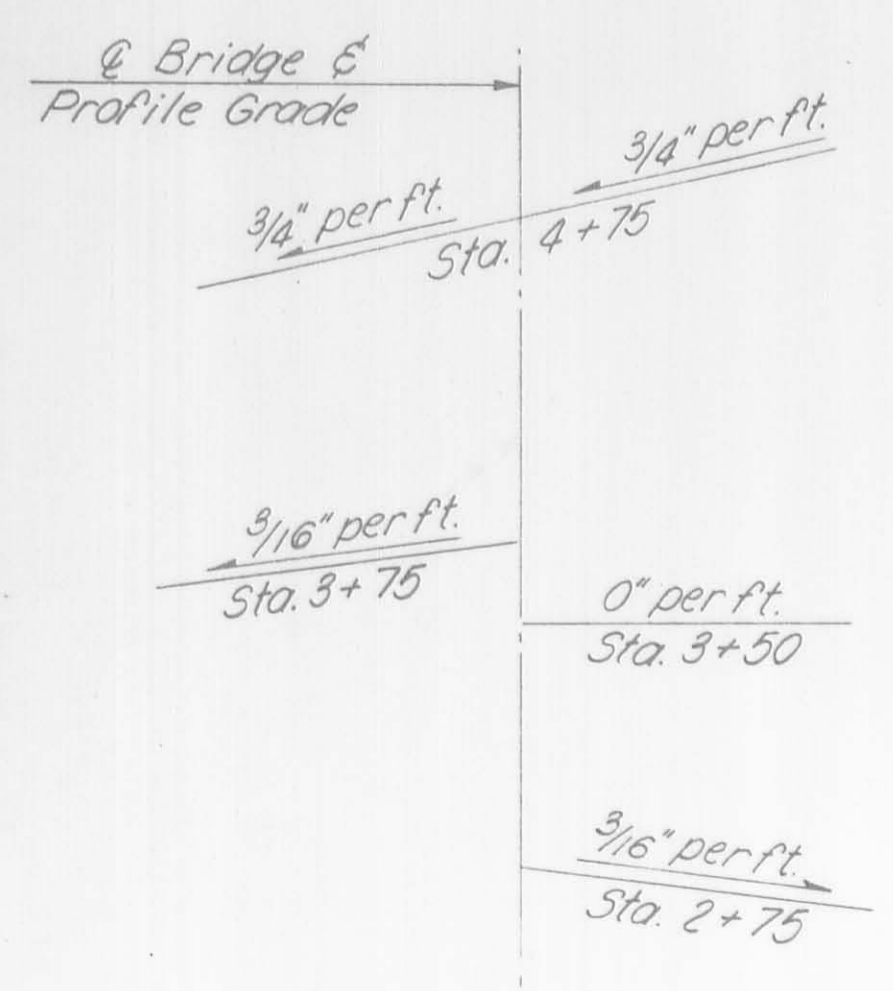

SUPERELEVATION DIAGRAM

| | | | | | |
|--|-------|---------|----------|---------|---------|
| ERIKSSON ENGINEERING COLUMBUS OHIO | | | | | |
| SUPERSTRUCTURE DETAILS | | | | | |
| BRIDGE NO. 29-2.70 CH. 29 OVER MAD RIVER | | | | | |
| LOGAN COUNTY, STA. 3+12.00 TO STA. 4+20.09 | | | | | |
| Designed | Drawn | Checked | Reviewed | Date | Revised |
| V.K. | G.S. | bb | | 5-20-75 | |

REINFORCING STEEL LIST

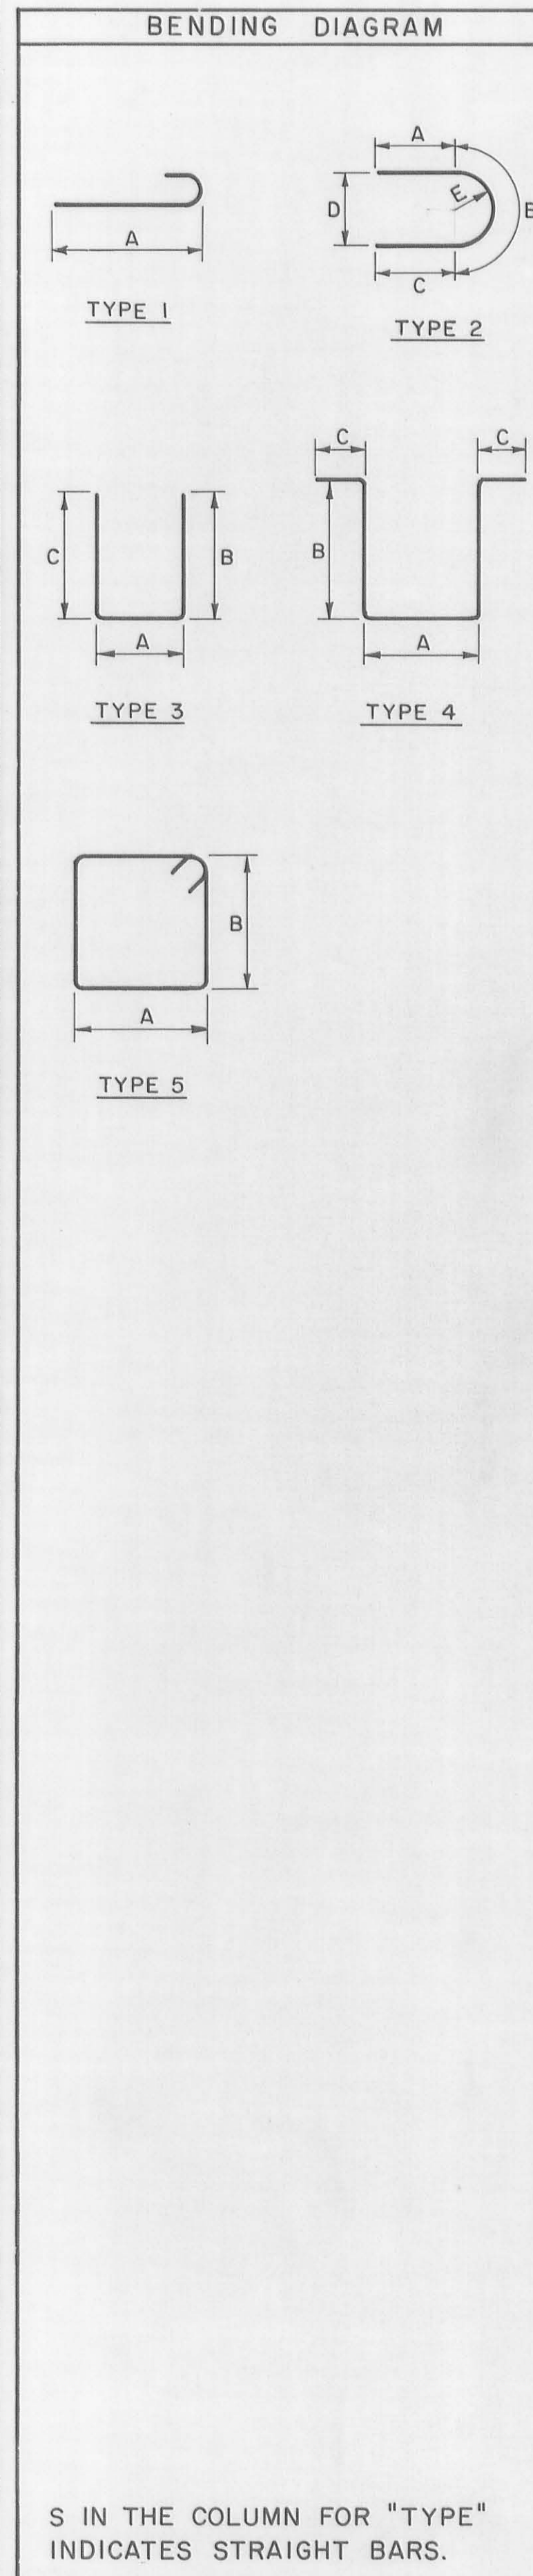

| MARK | NO. | LENGTH | WEIGHT | TYPE | A | B | C | D | E |
|-----------------------|-----|--------|--------|------|------|-------------------|------|---|---|
| ABUTMENT NO. 1 | | | | | | | | | |
| T401 | 14 | 8-8 | 81 | 5 | 1-9 | 2-4 $\frac{3}{4}$ | | | |
| T501 | 10 | 21-4 | 223 | 5 | | | | | |
| T502 | 68 | 6-5 | 455 | 3 | 2-8 | 2-0 | 2-0 | | |
| T503 | 2 | 17-6 | 37 | 5 | | | | | |
| T504 | 8 | 10-8 | 89 | 3 | 0-11 | 5-0 | 5-0 | | |
| T505 | 23 | 7-11 | 190 | 3 | 1-8 | 3-3 | 3-3 | | |
| T506 | 6 | 5-6 | 34 | 5 | | | | | |
| T507 | 2 | 3-2 | 7 | 5 | | | | | |
| T508 | 2 | 2-9 | 6 | 5 | | | | | |
| T801 | 8 | 21-9 | 465 | 5 | | | | | |
| T1001 | 4 | 33-4 | 574 | 5 | | | | | |
| | | | 2,161 | | | | | | |
| ABUTMENT NO. 2 | | | | | | | | | |
| T411 | 14 | 8-8 | 81 | 5 | 1-9 | 2-4 $\frac{3}{4}$ | | | |
| T511 | 12 | 22-3 | 278 | 5 | | | | | |
| T512 | 68 | 6-5 | 455 | 3 | 2-8 | 2-0 | 2-0 | | |
| T513 | 4 | 17-6 | 73 | 5 | | | | | |
| T514 | 4 | 10-8 | 45 | 3 | 0-11 | 5-0 | 5-0 | | |
| T515 | 11 | 9-1 | 104 | 3 | 1-8 | 3-10 | 3-10 | | |
| T515 | 12 | 10-3 | 128 | 3 | 1-8 | 4-5 | 4-5 | | |
| T516 | 6 | 12-8 | 79 | 3 | 0-11 | 6-0 | 6-0 | | |
| T517 | 4 | 5-0 | 21 | 5 | | | | | |
| T518 | 2 | 2-9 | 6 | 5 | | | | | |
| T519 | 4 | 7-6 | 31 | 5 | | | | | |
| T520 | 2 | 5-0 | 10 | 5 | | | | | |
| T811 | 8 | 22-7 | 482 | 5 | | | | | |
| T1011 | 4 | 33-4 | 574 | 5 | | | | | |
| | | | 2,367 | | | | | | |

| MARK | NO. | LENGTH | WEIGHT | TYPE | A | B | C | D | E |
|-----------------------|-----|--------|--------|------|------|-------------------|-------------------|-------------------|--------------------|
| PIERS | | | | | | | | | |
| P401 | 28 | 8-0 | 150 | 5 | 1-9 | 2-0 $\frac{1}{4}$ | | | |
| P501 | 4 | 31-0 | 129 | 5 | | | | | |
| P502 | 8 | 6-4 | 53 | 2 | 1-8 | 1-8 | 3-0 | 2-0 $\frac{1}{4}$ | 0-11 $\frac{1}{2}$ |
| P503 | 52 | 8-7 | 466 | 4 | 2-2 | 2-10 | 0-7 $\frac{1}{2}$ | | |
| P504 | 4 | 3-10 | 16 | 3 | 2-10 | 0-7 $\frac{1}{2}$ | 0-7 $\frac{1}{2}$ | | |
| P901 | 8 | 31-0 | 843 | 5 | | | | | |
| P1001 | 8 | 34-5 | 1,185 | 5 | | | | | |
| | | | 2,842 | | | | | | |
| SUPERSTRUCTURE | | | | | | | | | |
| A1032 | 33 | 38-2 | 15,274 | 5 | | | | | |
| B1032 | 26 | 27-5 | 3,067 | 1 | 26-0 | | | | |
| C1032 | 26 | 25-8 | 2,872 | 1 | 24-3 | | | | |
| D1032 | 13 | 24-0 | 1,343 | 5 | | | | | |
| E1032 | 13 | 21-6 | 1,203 | 5 | | | | | |
| F1027 | 68 | 24-9 | 7,242 | 5 | | | | | |
| G1027 | 34 | 14-0 | 2,048 | 5 | | | | | |
| H1027 | 32 | 10-4 | 1,423 | 5 | | | | | |
| J501 | 68 | 24-0 | 1,702 | 5 | | | | | |
| K501 | 34 | 20-0 | 709 | 5 | | | | | |
| M601 | 102 | 34-5 | 5,273 | 5 | | | | | |
| M402 | 204 | 3-0 | 409 | 3 | 1-2 | 1-0 | 1-0 | | |
| N401 | 109 | 34-5 | 2,506 | 5 | | | | | |
| | | | 45,071 | | | | | | |

NOTES

BAR SIZE IS INDICATED IN THE BAR MARK. THE FIRST DIGIT WHERE THREE DIGITS ARE USED, AND THE FIRST TWO DIGITS WHERE FOUR ARE USED, INDICATE THE BAR SIZE NUMBER. FOR EXAMPLE, A700 IS A NO. 7 SIZE BAR AND A1014 IS A NO. 10 SIZE.

ERIKSSON ENGINEERING
COLUMBUS OHIO

REINFORCING STEEL LIST

BRIDGE NO. 29-2.70
C.H. 29 OVER MAD RIVER
LOGAN COUNTY, STA. 3+12.00 TO STA. 4+ 20.09

| Designed | Drawn | Checked | Reviewed | Date | Revised |
|----------|-------|------------|----------|---------|---------|
| V. K. | G. S. | <i>llb</i> | | 5-20-75 | |