
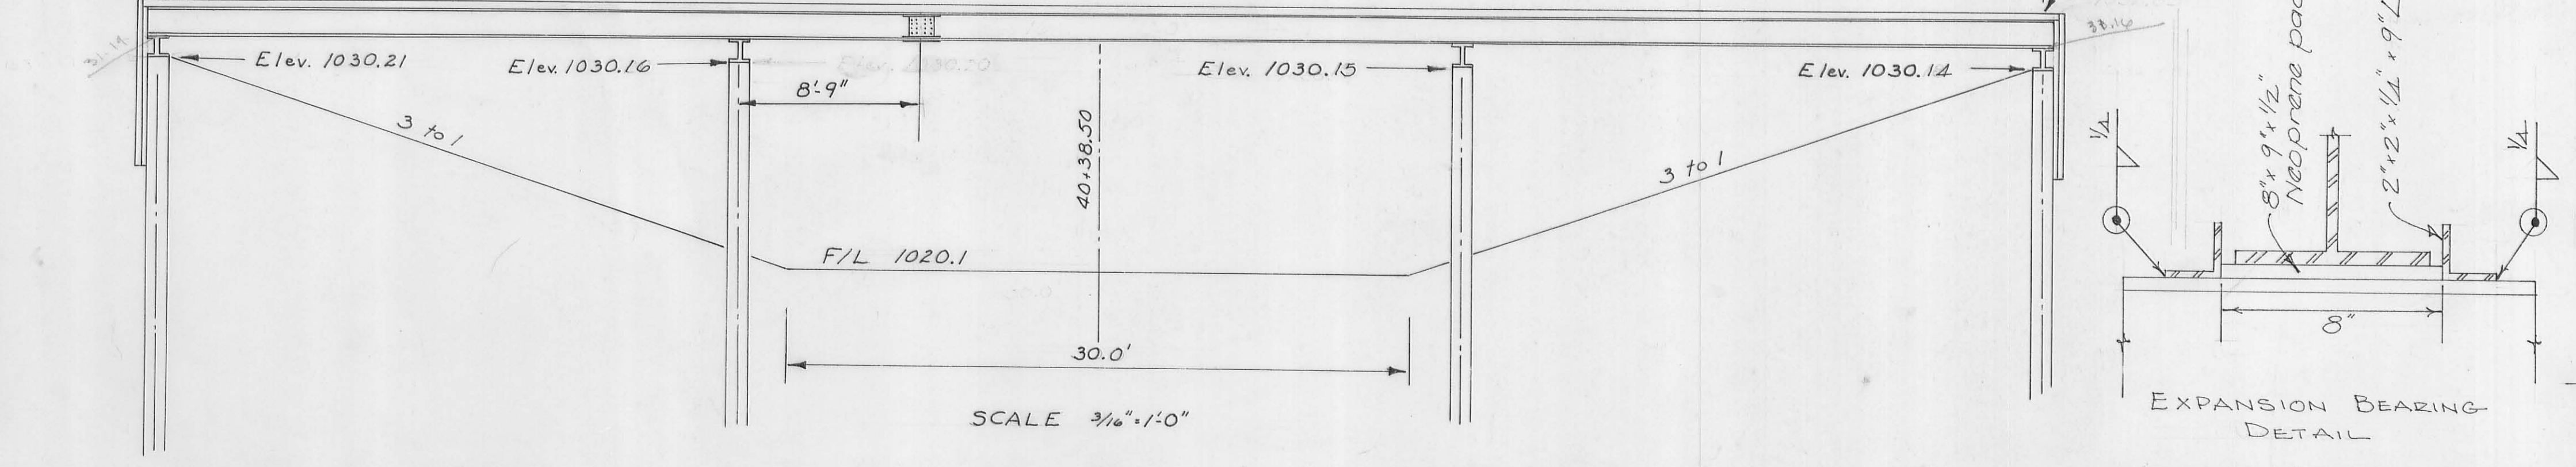
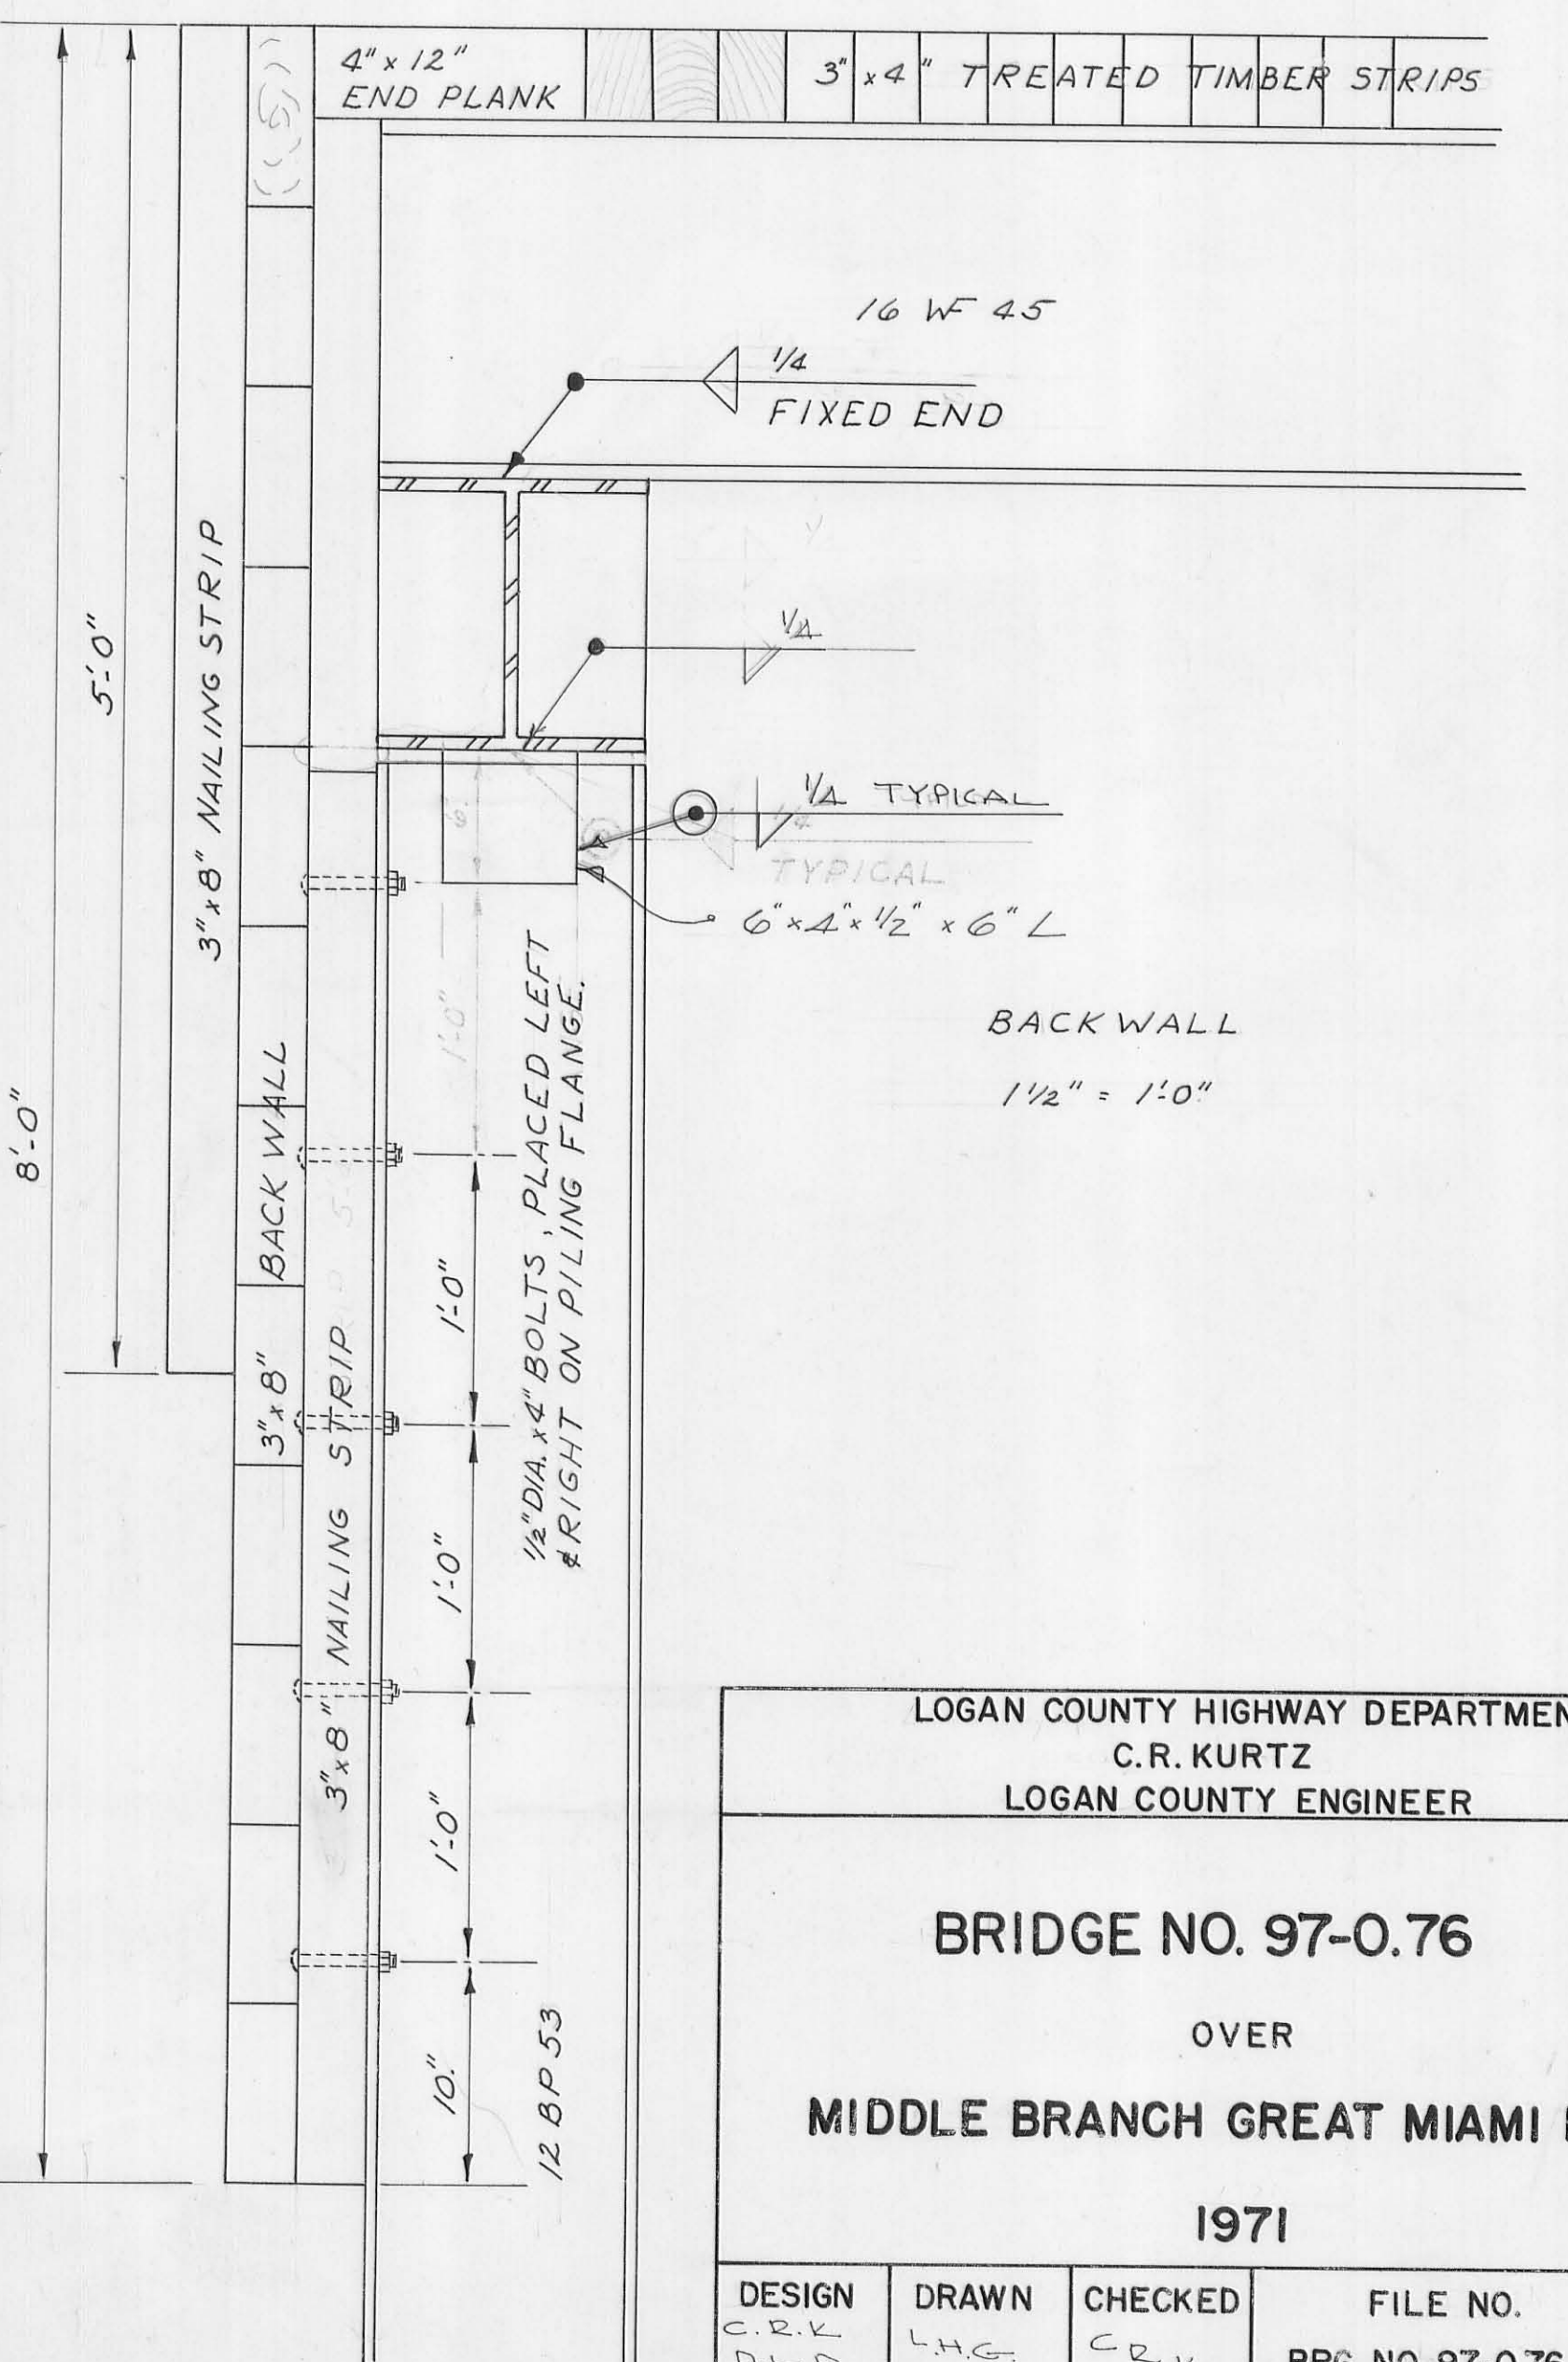
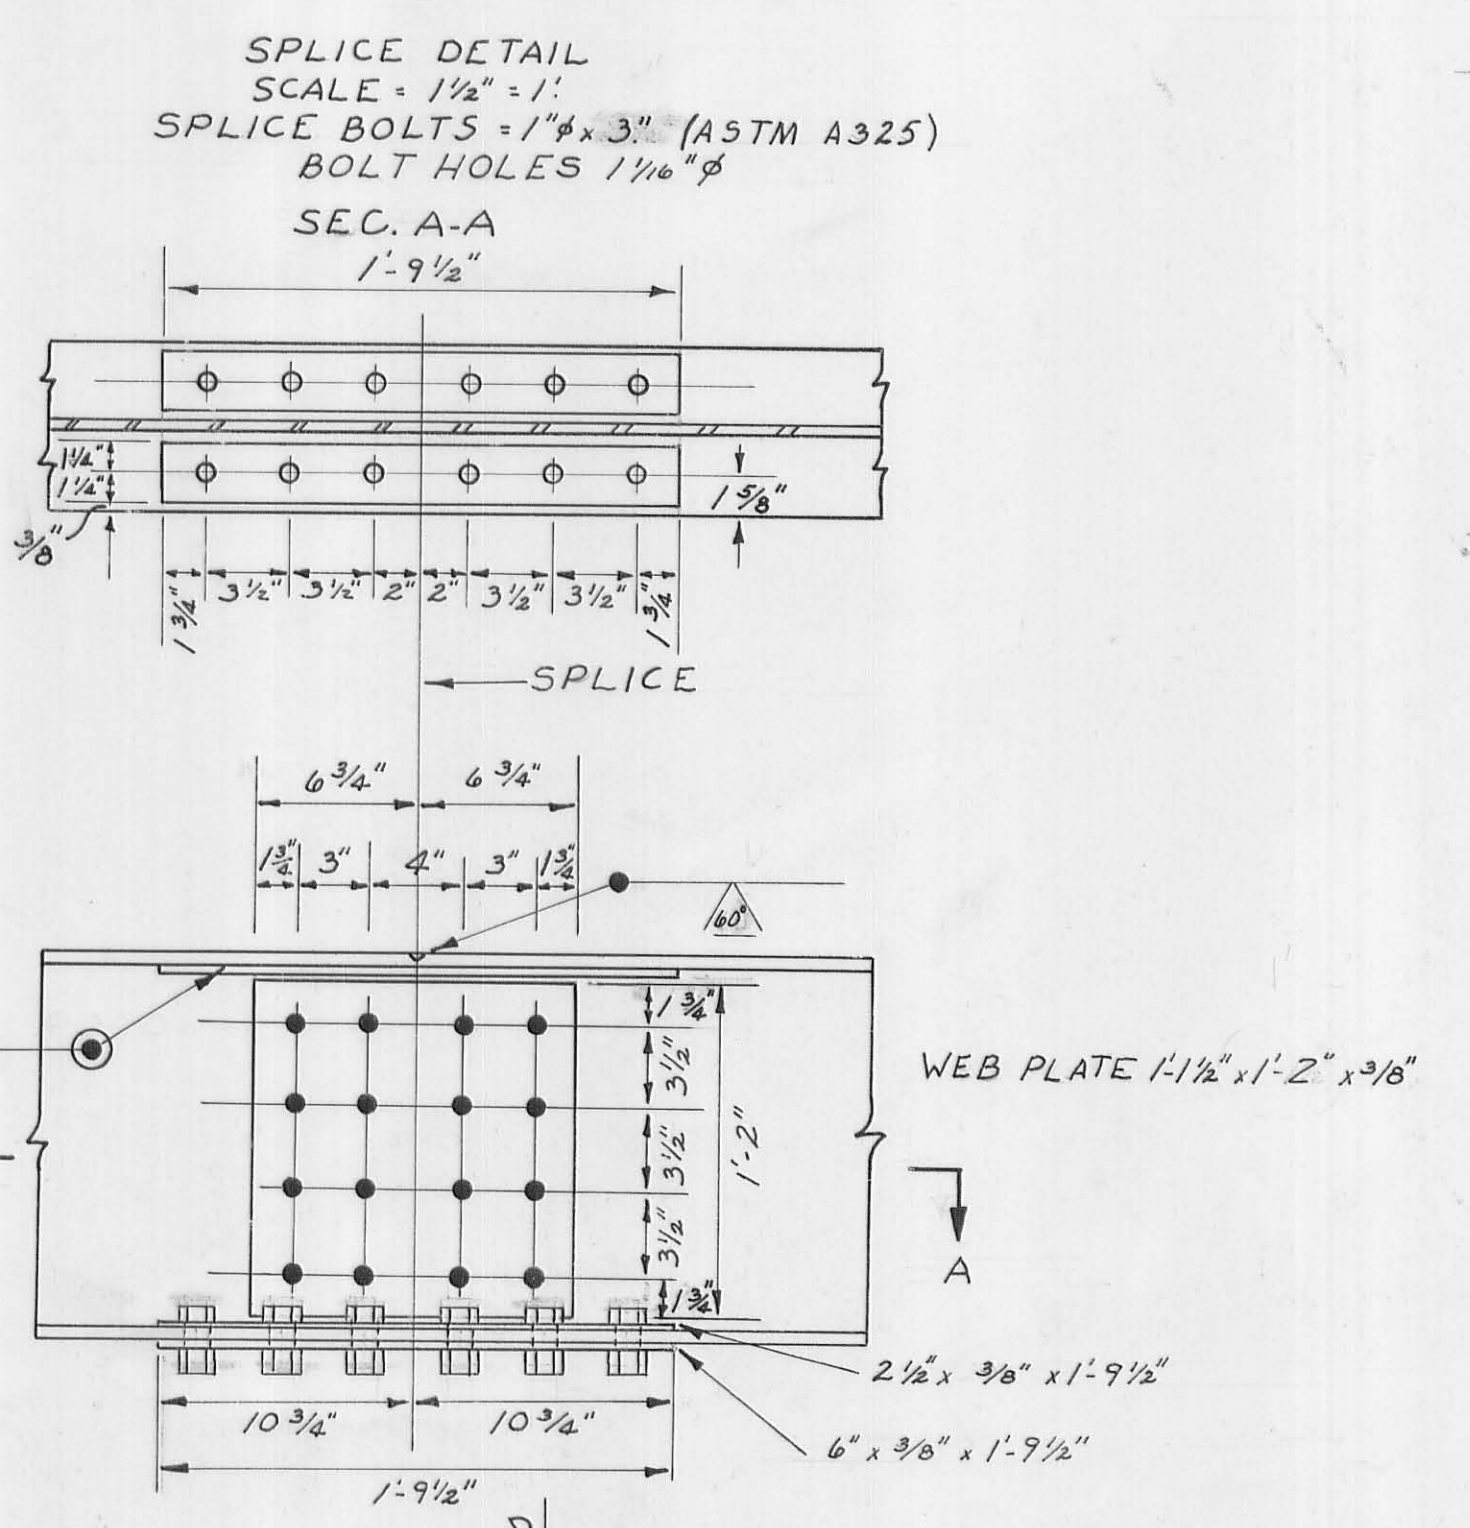
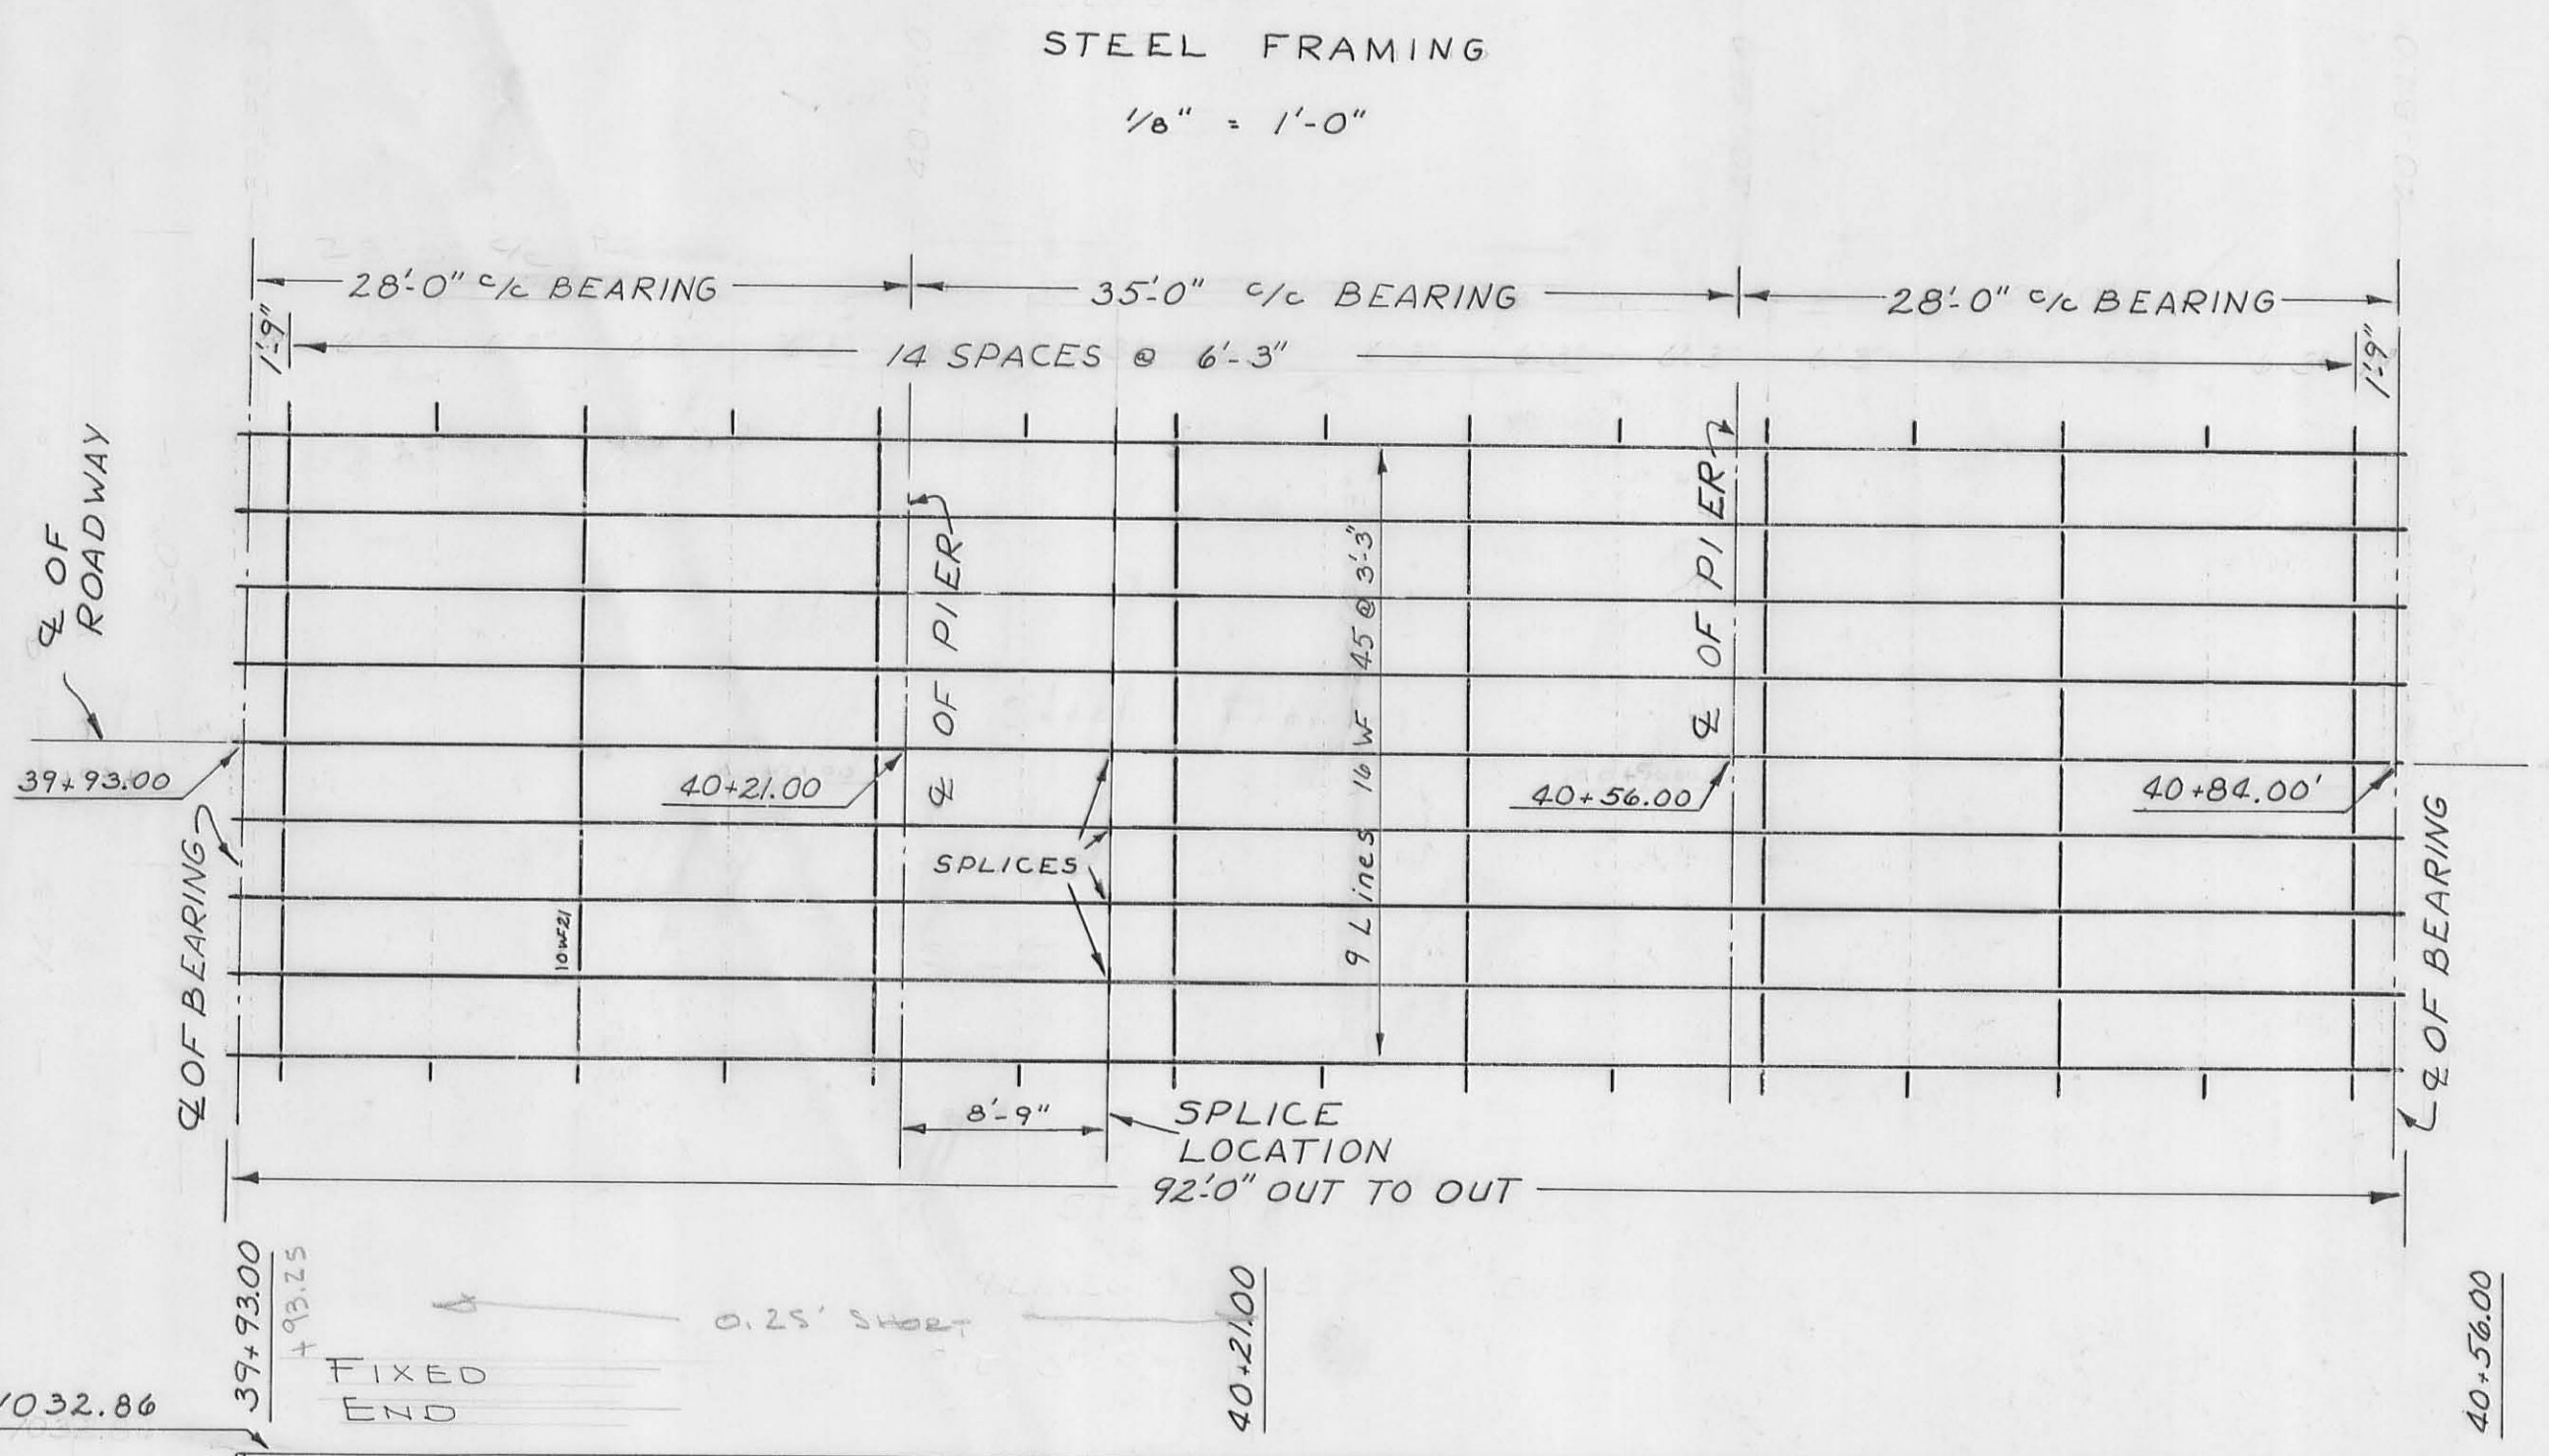
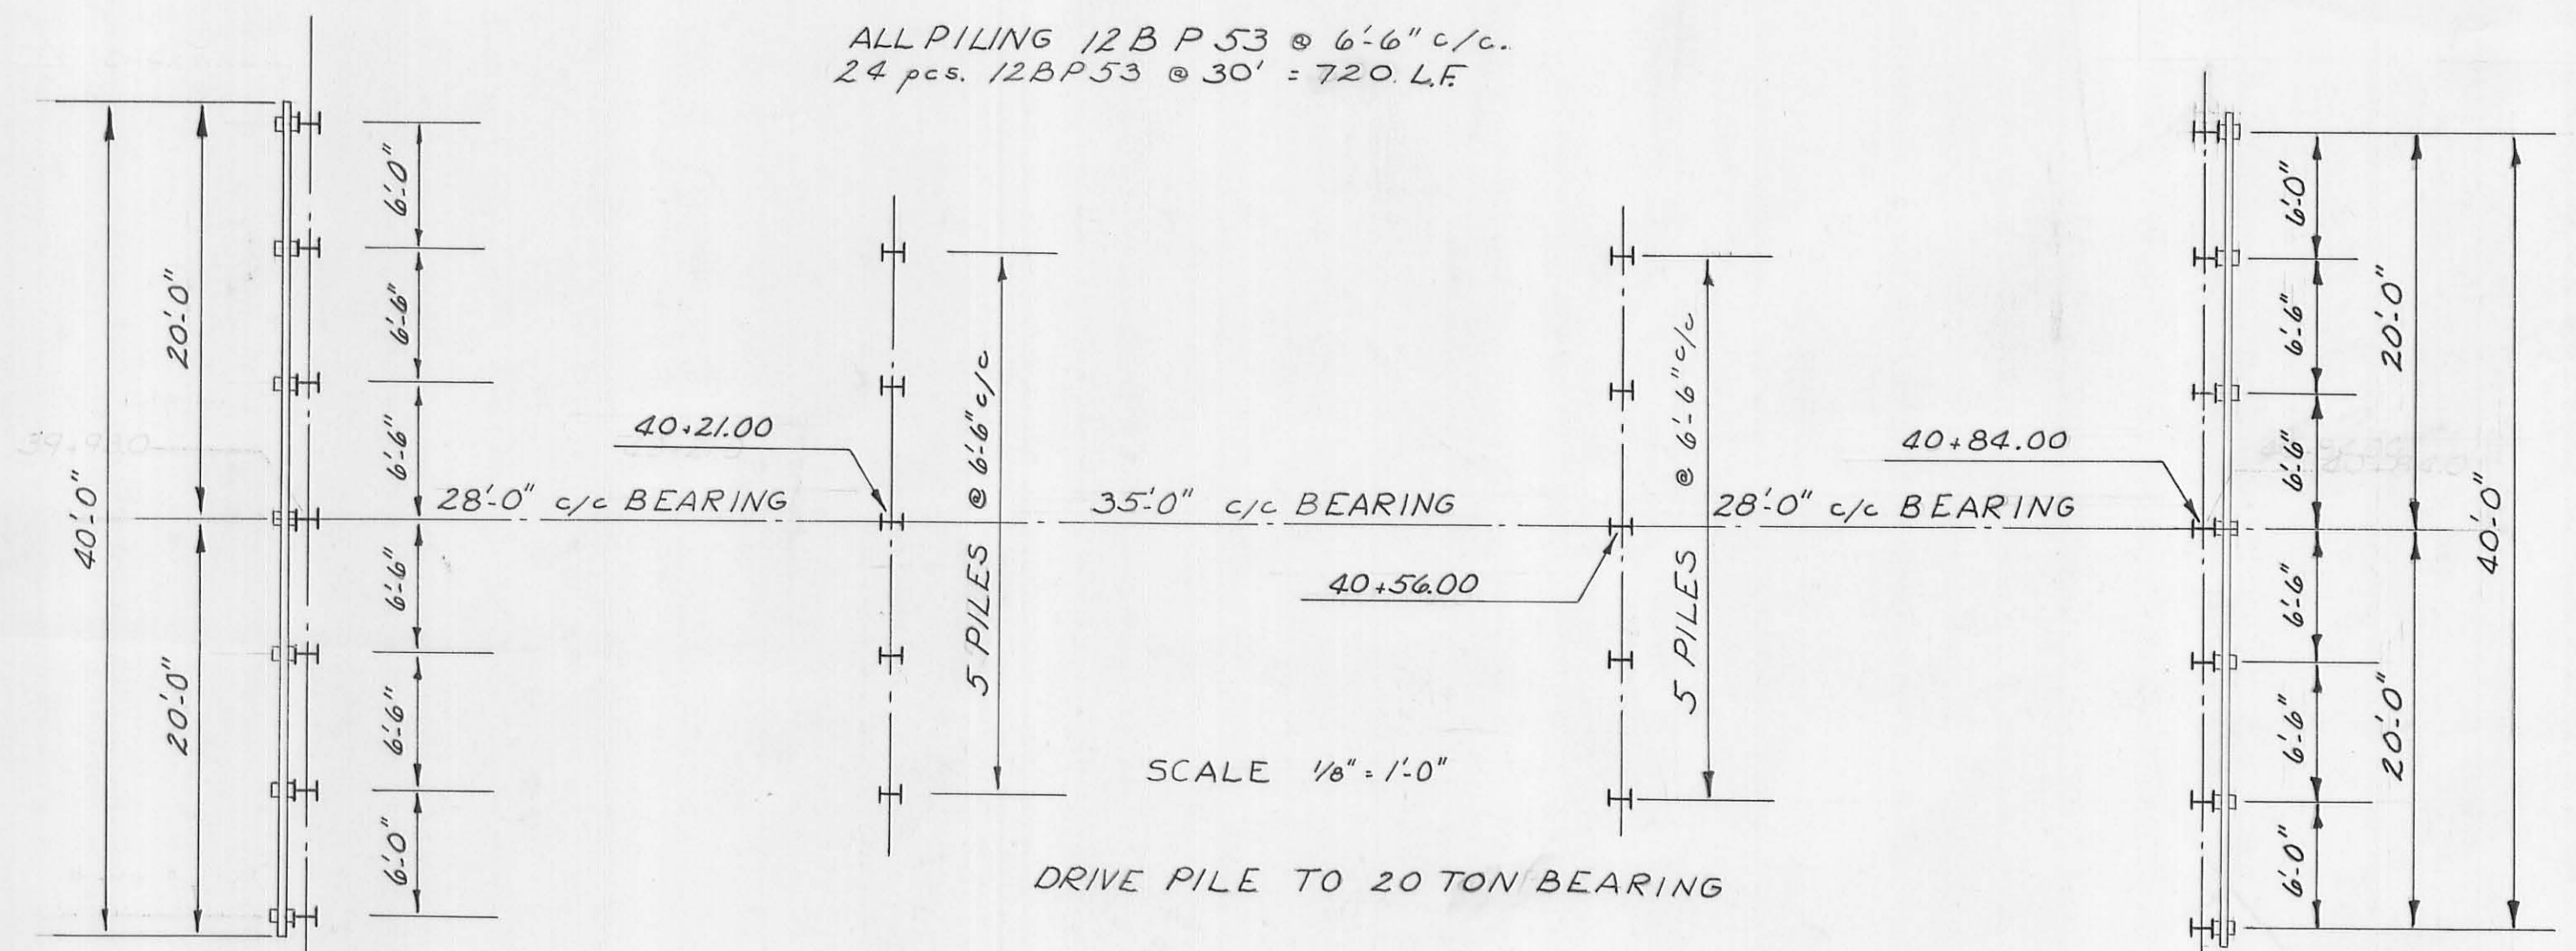


97-076

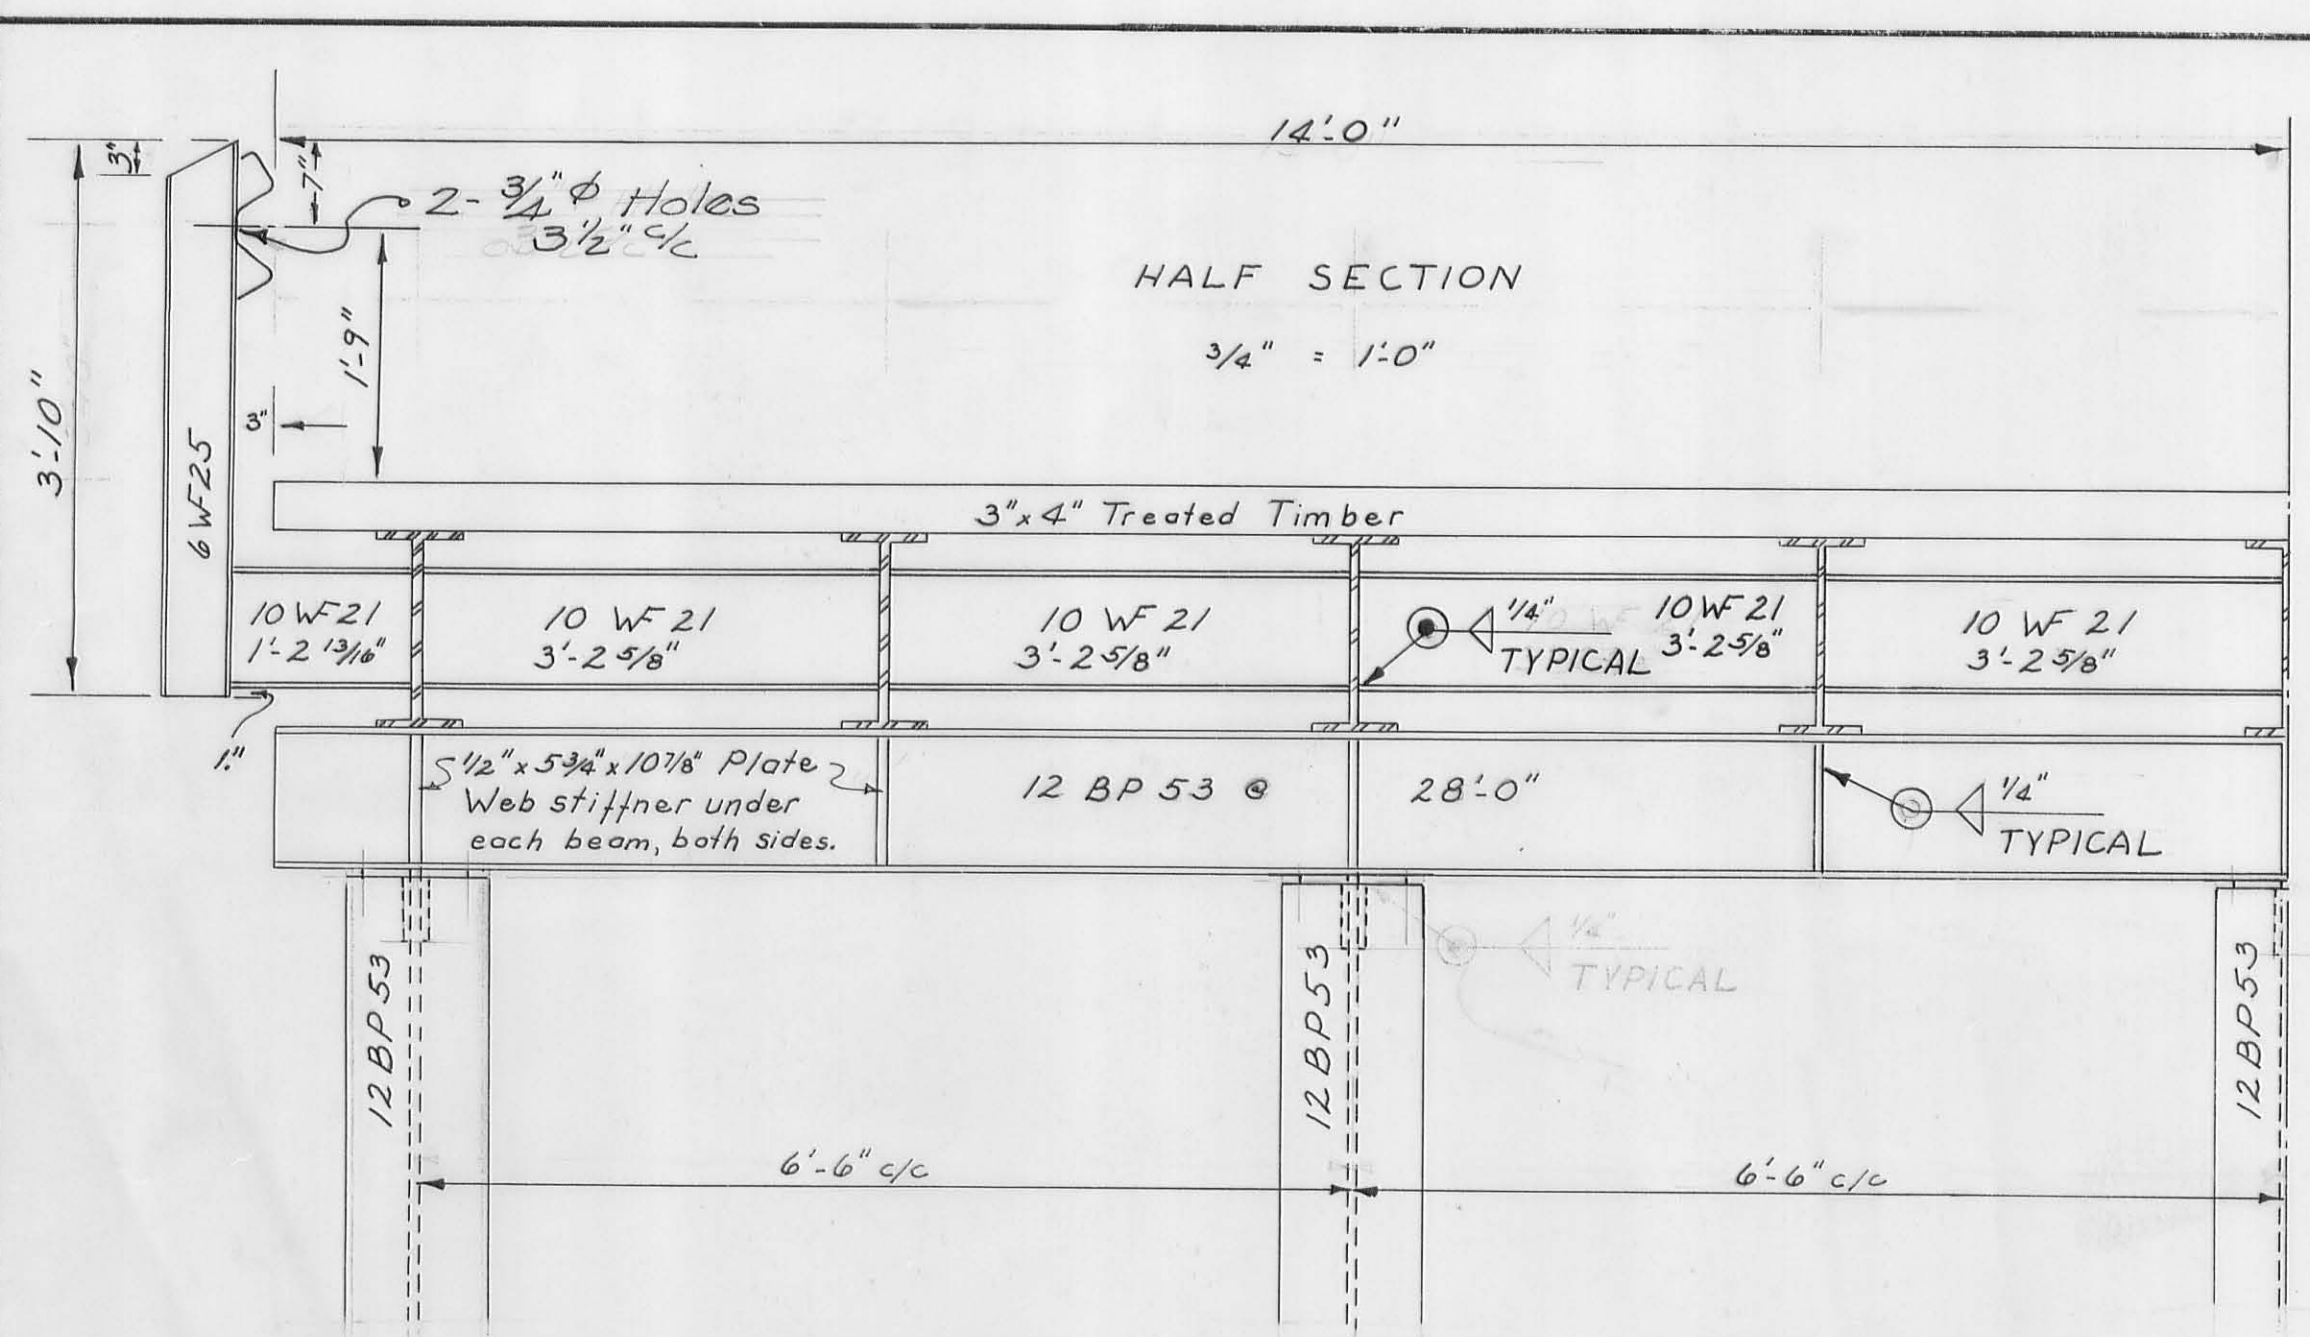

Train 1/10\"/>

LOGAN COUNTY HIGHWAY DEPARTMENT			
C.R. KURTZ			
LOGAN COUNTY ENGINEER			
BRIDGE NO. 97-0.76			
OVER			
MIDDLE BRANCH GREAT MIAMI RIVER			
1971			
DESIGN C.R.K. D.L.O.	DRAWN L.H.G.	CHECKED C.R.K.	FILE NO. BRG NO 97-0.76